




T.26S.,R.13W.,W.M.

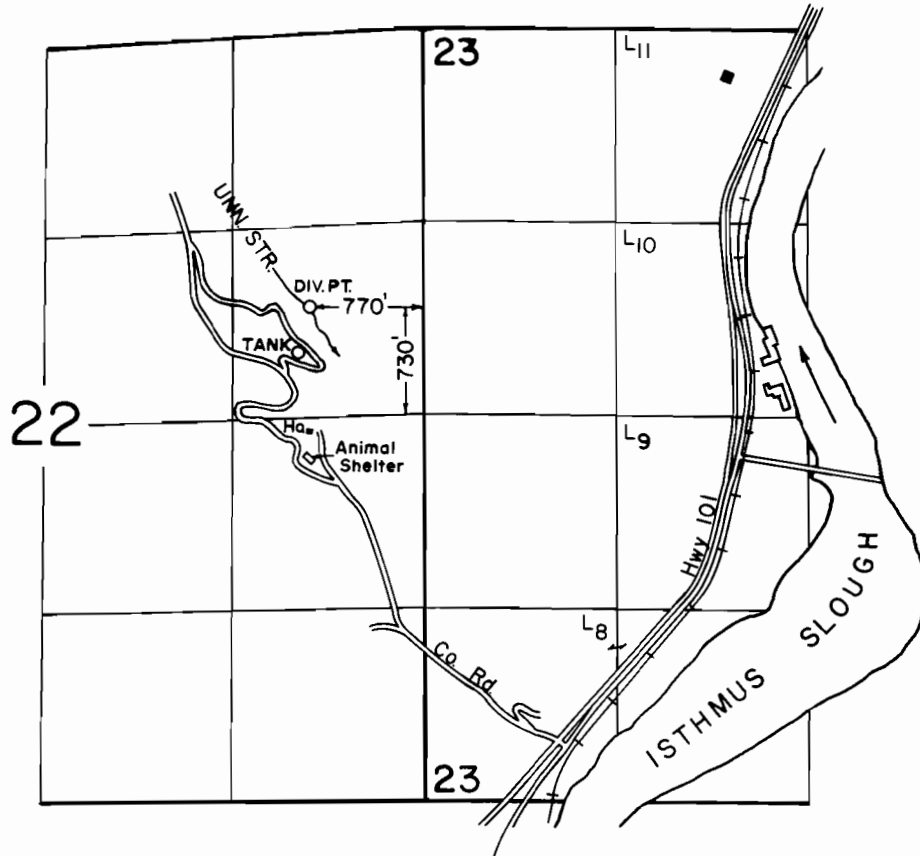

SCALE: 1" = 1320'

FINAL PROOF SURVEY
UNDER

Application No. 60913... Permit No. 46198...
IN NAME OF

COOS COUNTY ANIMAL SHELTER

Surveyed SEPT. 19. 1988., by J. R. KAUPPILA...