


T. 40 S., R. 14 W., W.M.

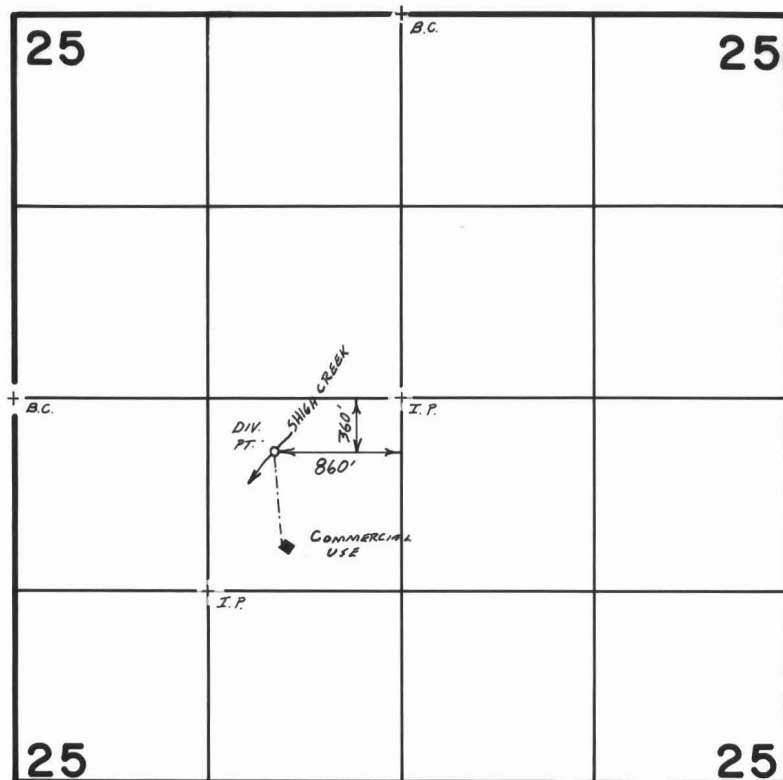

Scale 1" = 1320'



## FINAL PROOF SURVEY UNDER

Application No. 61115..... Permit No. 45761.....  
IN NAME OF

BROOKINGS ENERGY FACILITY, INC.

Surveyed Sept. 4, 1987, by J.M. SCHMORDE