


T13S, R11W, WM

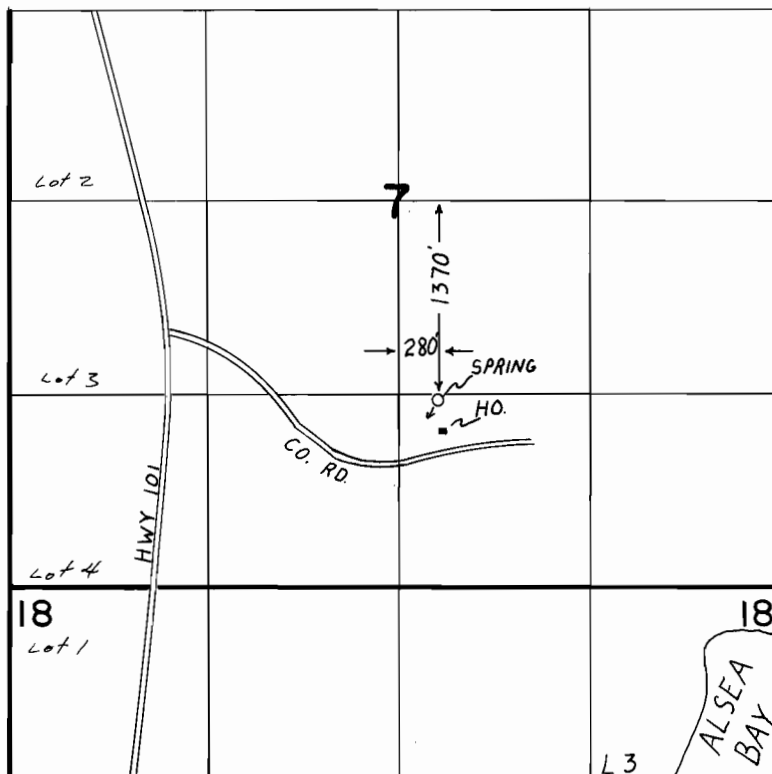

SCALE: 1" = 1320'

FINAL PROOF SURVEY UNDER

Application No. 61801 Permit No. 46133
IN NAME OF

DOUGLAS S. BOYD

Surveyed MAY 24, 1988, by T. M. WARREN