


T.9S.,R.4E.,W.M.

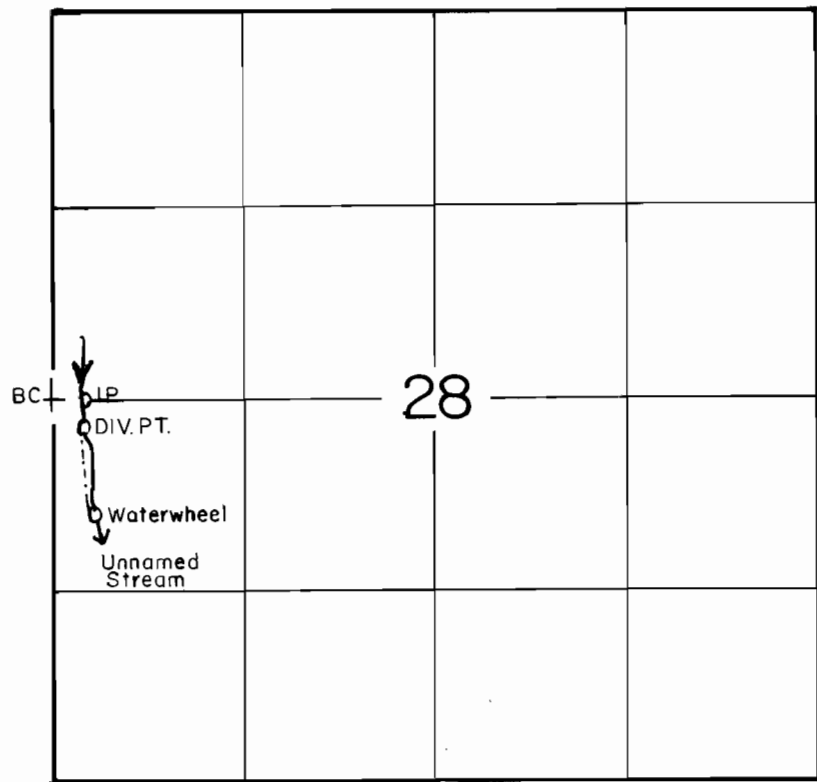

DIV. PT. LOC. 180'S. & 200'E. FROM THE WEST 1/4 COR SEC 28

SCALE: 1" = 1320'

FINAL PROOF SURVEY
UNDER

Application No. 65046.. Permit No. 47536.....
IN NAME OF

HENRY HIEBERT

Surveyed MAY 6..... 1986., by T.M. WARREN.....