


T. 2 S.,
R. 38 E.,
W. M.

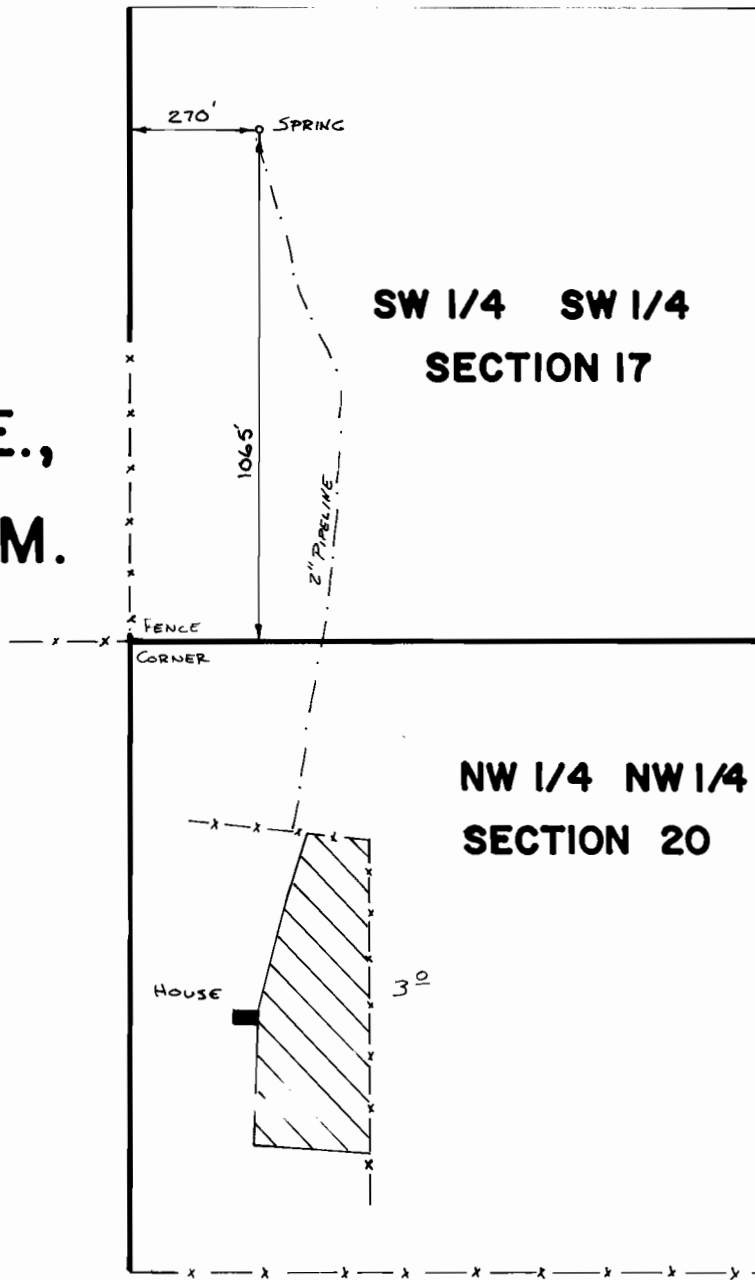

SCALE 1" = 400'

FINAL PROOF SURVEY
UNDER

Application No. **65091** Permit No. **47814**
IN NAME OF

MEDARD P. HUMISTON

Surveyed 5-5 1987, by V.L. Church