


T.2S., R.4W., W.M.

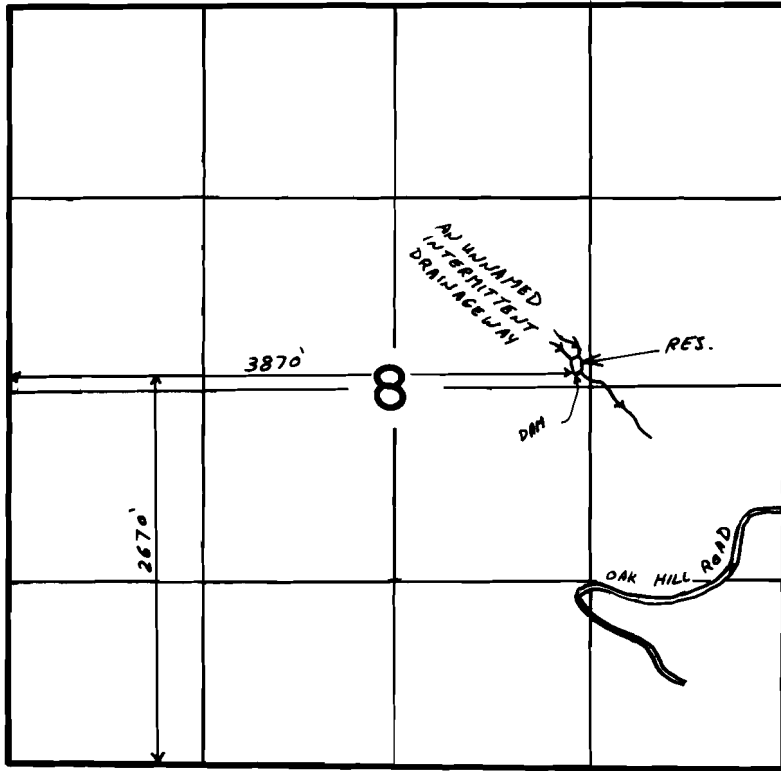

SCALE 1" = 1320'

FINAL PROOF SURVEY
UNDER

Application No. R-67331 Permit No. R-9269
IN NAME OF

ALTON F. GRABHORN

Surveyed OCT. 5 1988, by Z. SALEH

41071-178-58D
12-15-88 Z.F.S.