


T. 2N., R. 4W., W.M.

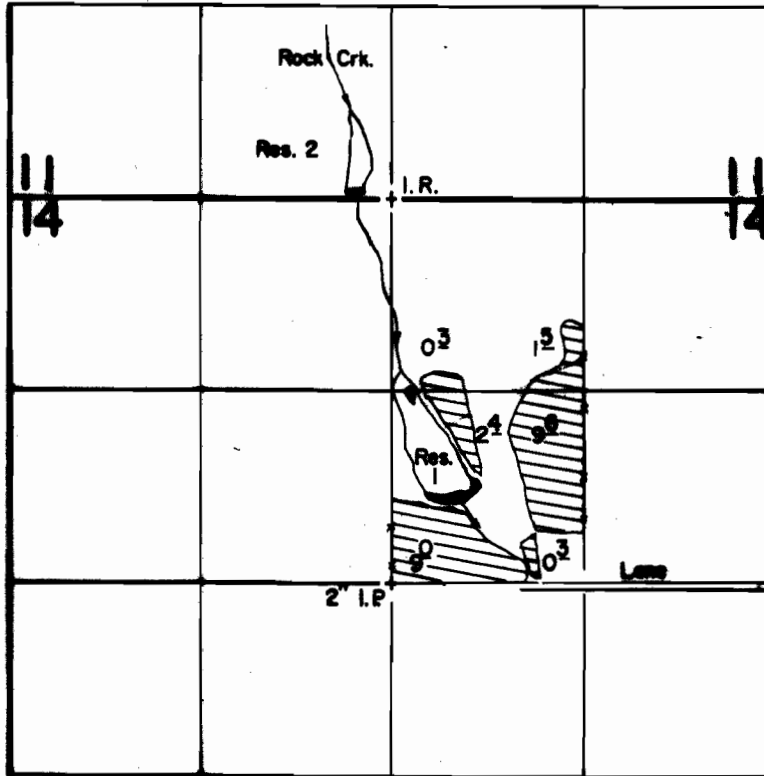

P.O.D. 1 Loc. : 600' N. & 400' E. from C-1/4 Cor., Sec. 14.
P.O.D. 2 Loc. : 20' N. & 230' W. from S-1/4 Cor., Sec. 11.

Scale : 1" = 1320'

FINAL PROOF SURVEY
UNDER

R-67689

R-9602

Application No. 64595 Permit No. 48331

IN NAME OF

TED C. NEWARD

Surveyed AUG 10 1988, by T. Warren