


T. 38 S., R. 2 & 3 W., W. M.

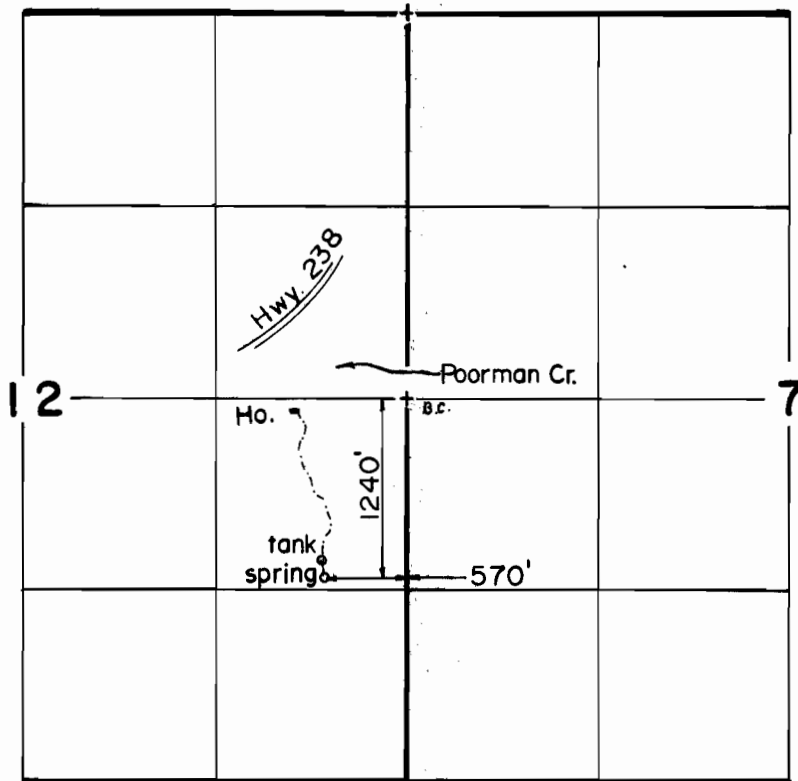

Scale: 1" = 1320'

FINAL PROOF SURVEY
UNDER

Application No. ~~67726~~ Permit No. ~~48410~~
IN NAME OF

BRIAN MISCHE

Surveyed AUG. 10. 1988., by B. S. JAMES.