


T.3S., R.2W., W.M.

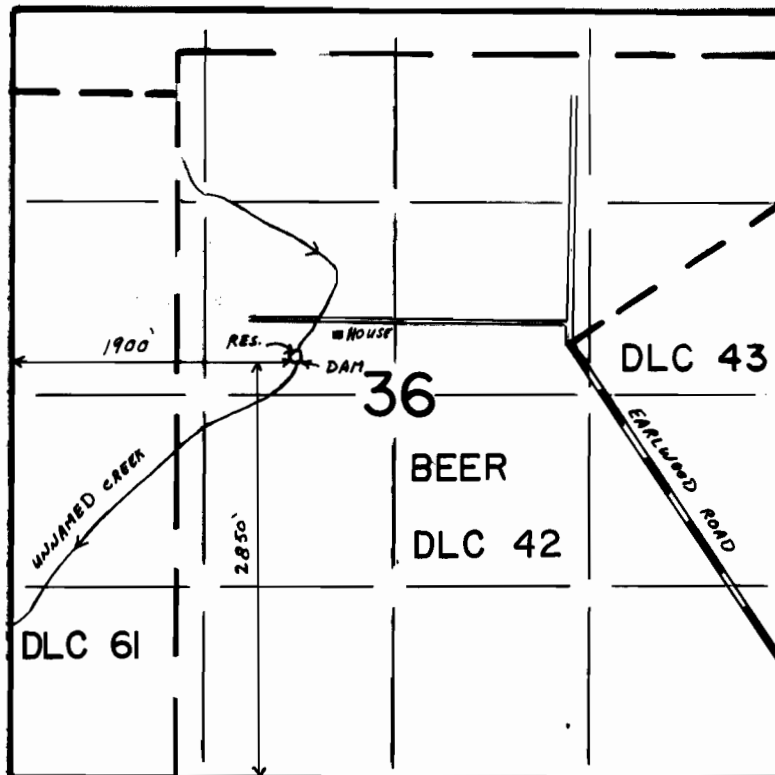

SCALE 1"=1320'

FINAL PROOF SURVEY
UNDER

Application No. ~~R-68183~~ Permit No. ~~R-10532~~....
IN NAME OF

STEVEN L. MANNERS

Surveyed **OCT. 10 1988**, by **Z. SALEH**

41071-178-168 R
12-16-88 Z.F.S.