


T. 26 S., R. 3 W., W.M.

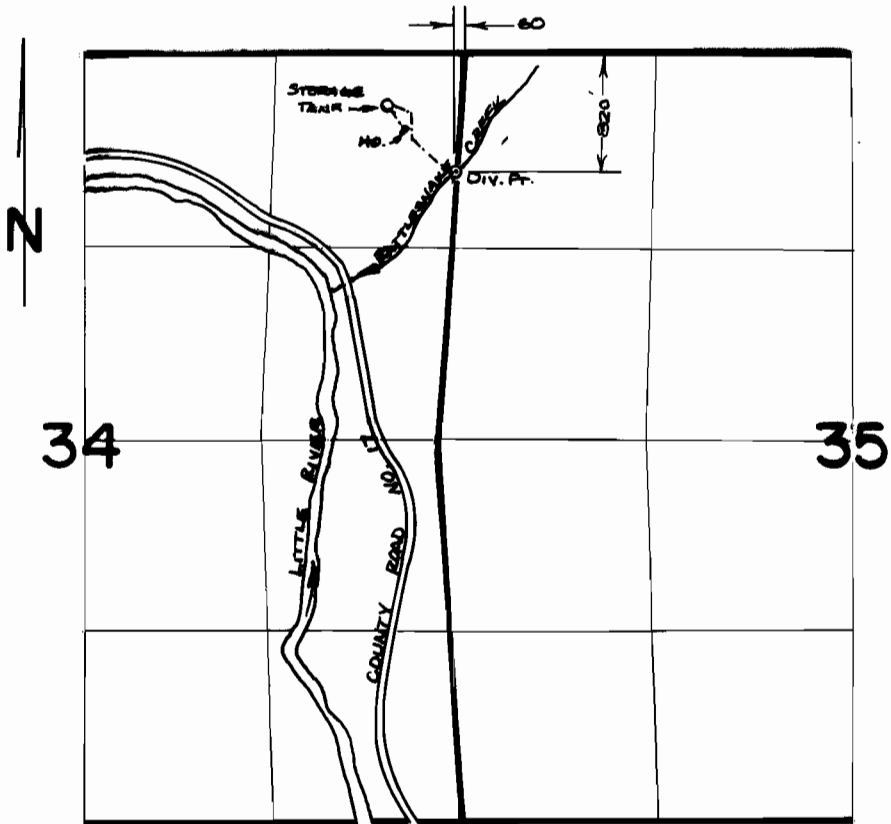

SCALE : 4" = 1 MILE

FINAL PROOF SURVEY UNDER

Application No. .68189... Permit No. .49025.....
IN NAME OF

.....RICHARD R. HOWARD.....

Surveyed .FEB..8,.. 19.88., by ..J.M.SCHMORDE..