


T. 40 S., R. 3 W., W. M.

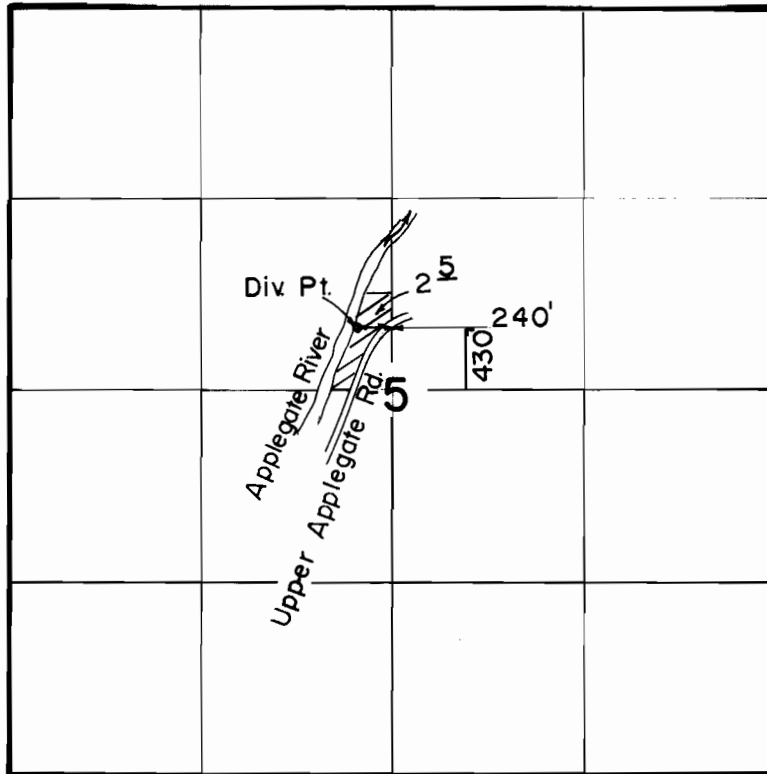

Scale: 1" = 1320'

**FINAL PROOF SURVEY**  
UNDER

Application No. 68385 Permit No. 49434  
IN NAME OF

RONALD H. JONES

Surveyed NOV. 2 1987, by B. S. JAMES