


T. 40 S., R. 13 W., W. M.

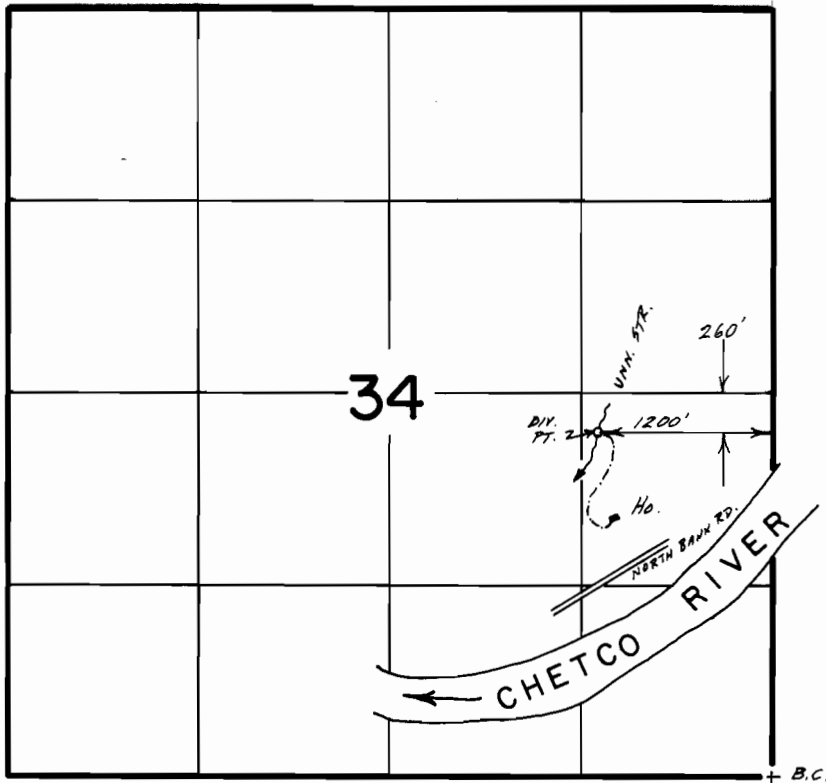

SCALE 1"=1320'

FINAL PROOF SURVEY
UNDER

Application No. ~~68725~~ Permit No. ~~49751~~.....
IN NAME OF

RALPH & JUNE BLACKBURN

Surveyed Sept. 29, 1987., by J.M.SCHMORDE