


T. 41 S., R. 12 W., W.M.

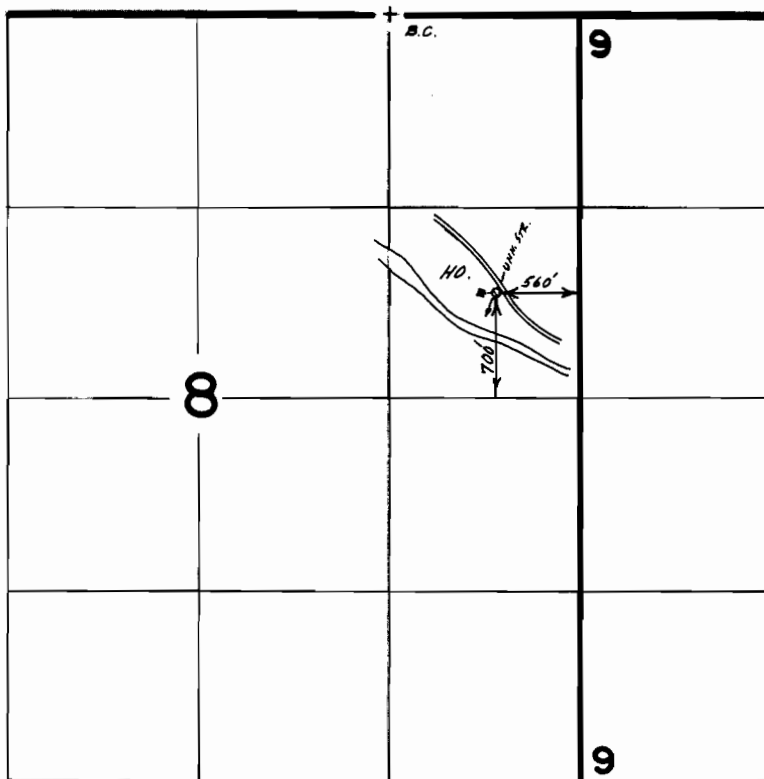

Scale 1" = 1320'

FINAL PROOF SURVEY UNDER

Application No. 68739. Permit No. 49886....
IN NAME OF

...RALPH L. & PEGGY J. MORY...

Surveyed Oct. 8, 1988, by B.S. JAMES.....