


T5N, R7W, WM

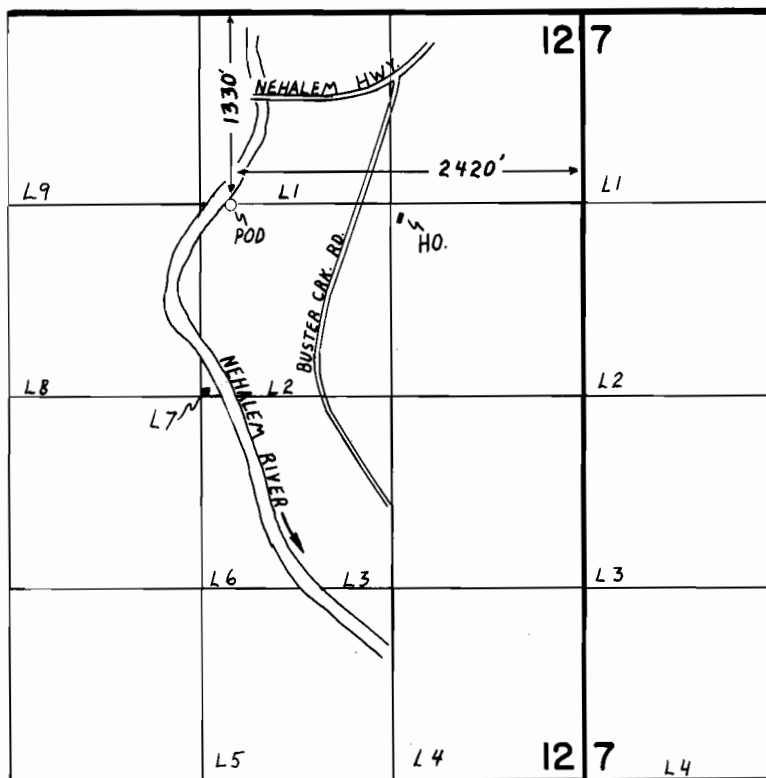

1" = 1320'

FINAL PROOF SURVEY UNDER

Application No. 68790 Permit No. 49894
IN NAME OF

JOHN T. & LINDA K. RINKES

Surveyed AUG. 15, 1988, by T. M. WARREN.