


T. 6N., R. 2W., W.M.

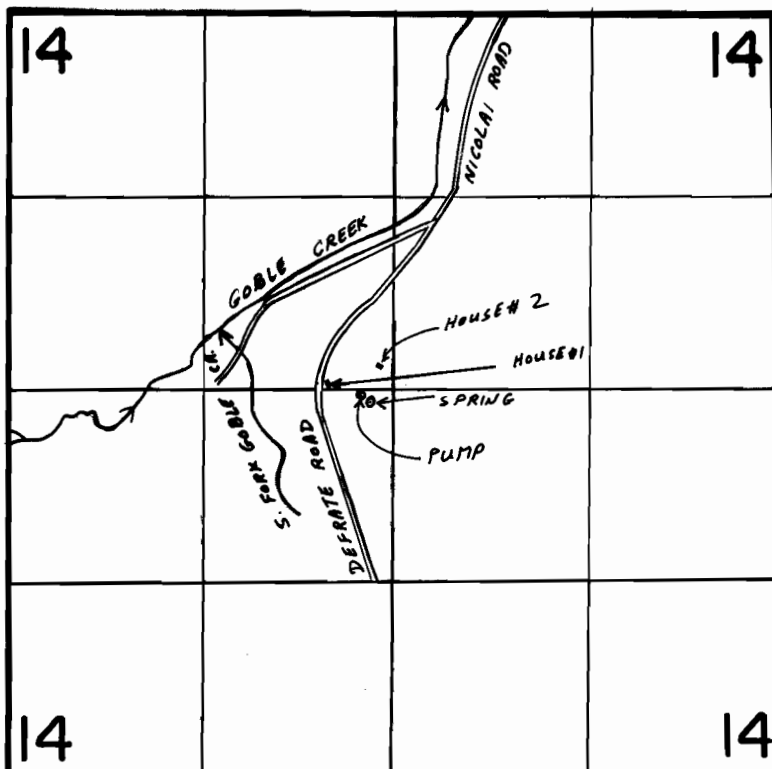

DIV. POINT: 70' S & 130' W FROM THE CENTER OF SEC. 14

SCALE 1" = 1320'

FINAL PROOF SURVEY
UNDER

Application No. **68792** Permit No. **49724**
IN NAME OF

GORDON WILLIAM DALBY

Surveyed **AUG. 23 88** by **Z. SALEH**

15-96-SE 1/4
12-20-88 Z.F.S.