


T.9S., R.45E.,W.M.

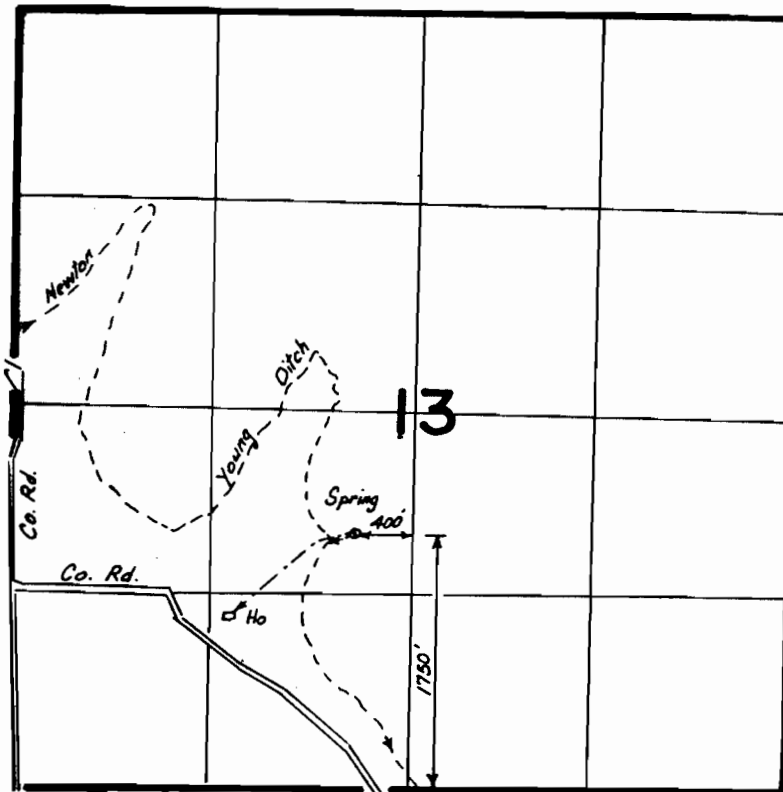

Scale: 1" = 1320'

FINAL PROOF SURVEY
UNDER

Application No. 68827. Permit No. 49925....
IN NAME OF

ORVILLE WOODS & ELAINE WOODS

Surveyed 10-6..... 1988, by Kenn Kemp.....

BBB-9N-70 KK