


T. 15S. R. 5W. W.M.

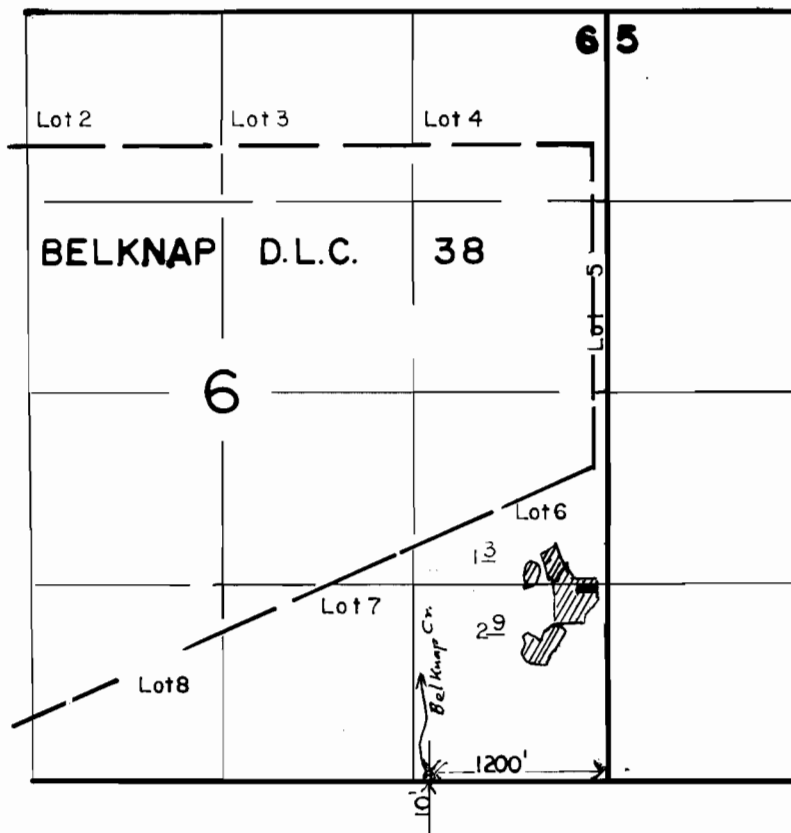

SCALE: 1" = 1320'

FINAL PROOF SURVEY UNDER

Application No. **62430**... Permit No. **46946**.....
IN NAME OF

GEORGE WHEELER & LESLIE REDPATH

Surveyed **NOV. 16**... 1987., by **T.M. WARREN**.....