


T.41S.R.19E.W.M.

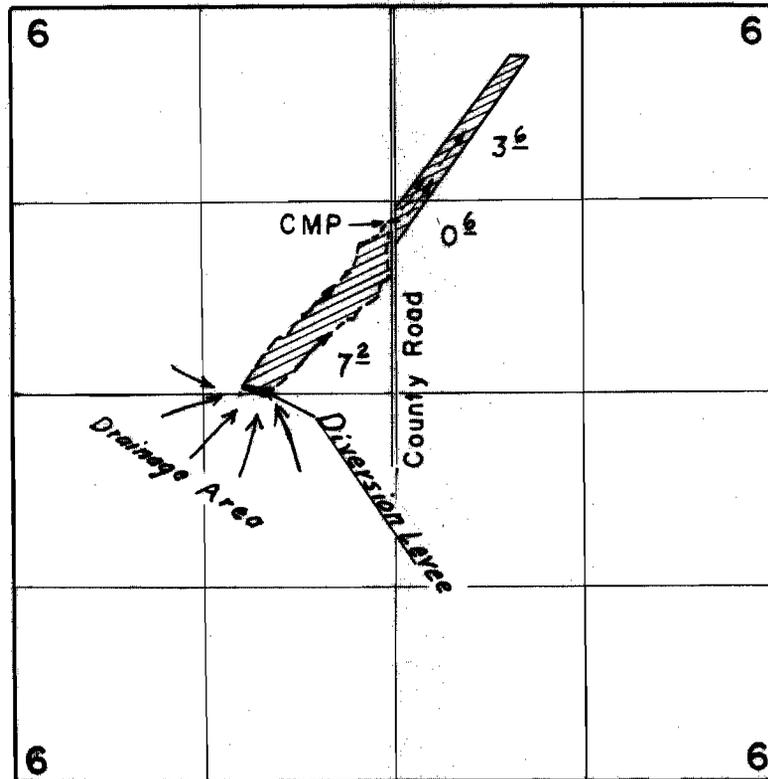

**FINAL PROOF SURVEY**  
UNDER

Application No. 34019... Permit No. 27313...  
IN NAME OF

.....Mrs. Urcie Lamb.....

Surveyed Sept. 15, 1964, by C.J. Gardner.....