


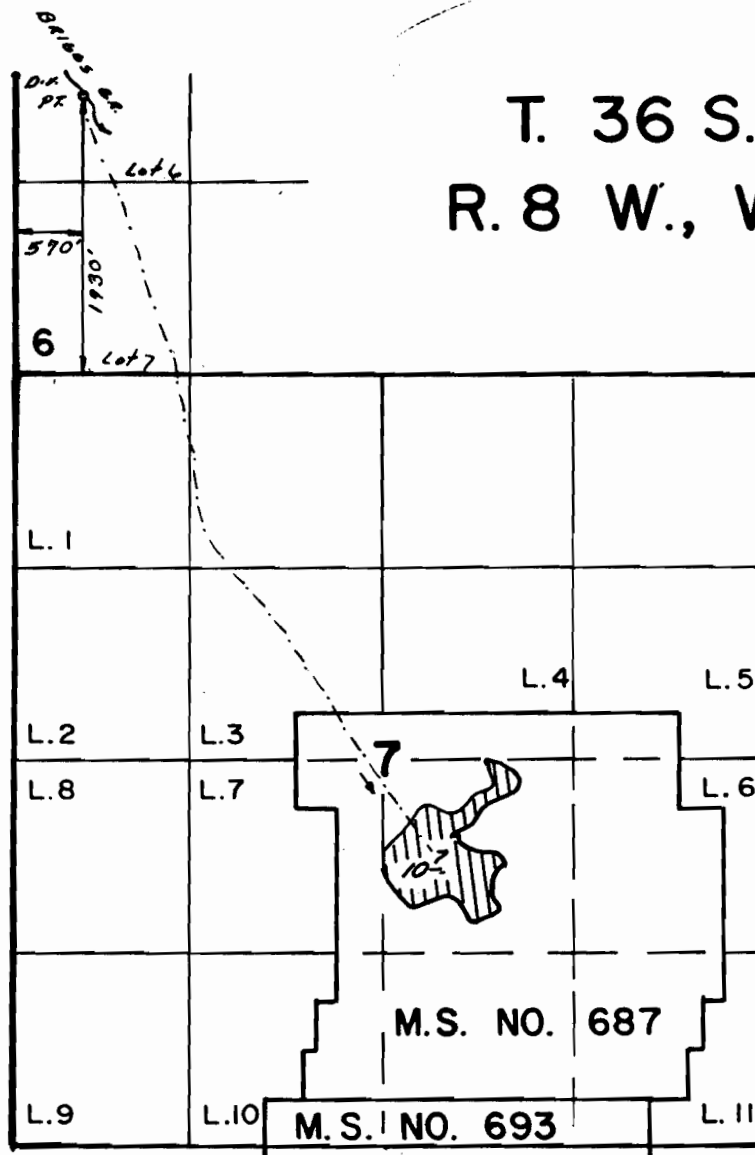

T. 36 S.,
R. 8 W., W. M.



Scale:
1" = 1320'

FINAL PROOF SURVEY UNDER

Application No. 57667 Permit No. 43430
IN NAME OF

EDWARD A. PLEGEL

Surveyed OCT. 29. 19.87. by B. S. JAMES.