




T. 1 S. R. 4 E., W.M.

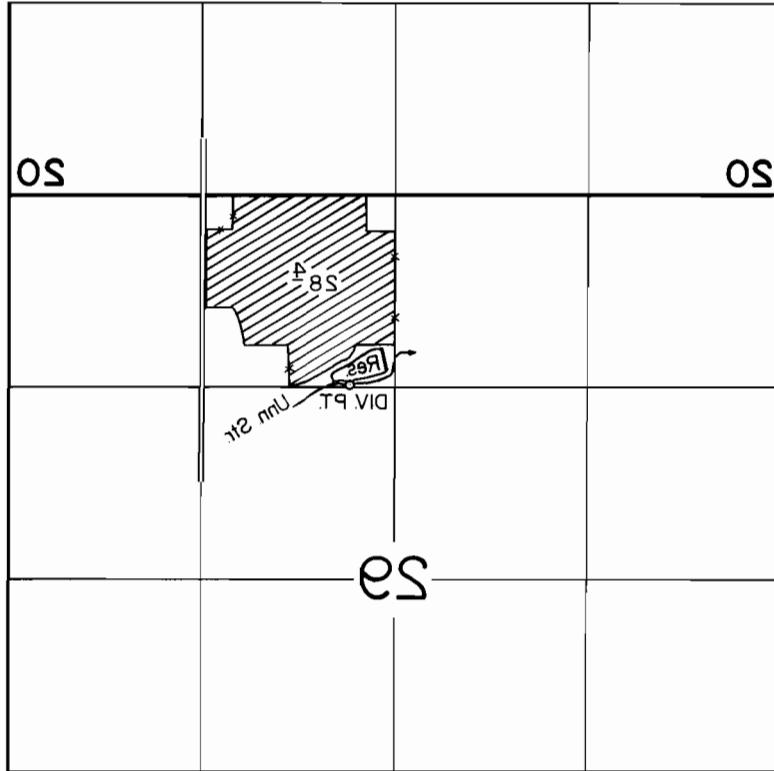

DIV. PT. LOC. 1300.2' & 350.0' E. FROM N 1/4 CORNER SECTION 28
DAM LOC. 1130.2' & 70.0' E. FROM N 1/4 CORNER SECTION 28

SCALE: 1" = 1350'

FINAL PROOF SURVEY UNDER

Application No. 27680 Permit No. 43762
IN NAME OF

CLIFFORD H. PAUL

Surveyed OCT. 7, 1986, by T. WARREN

Revised: 1-24-89

41002-578-23A