




T.27 S., R.11 W., W.M.

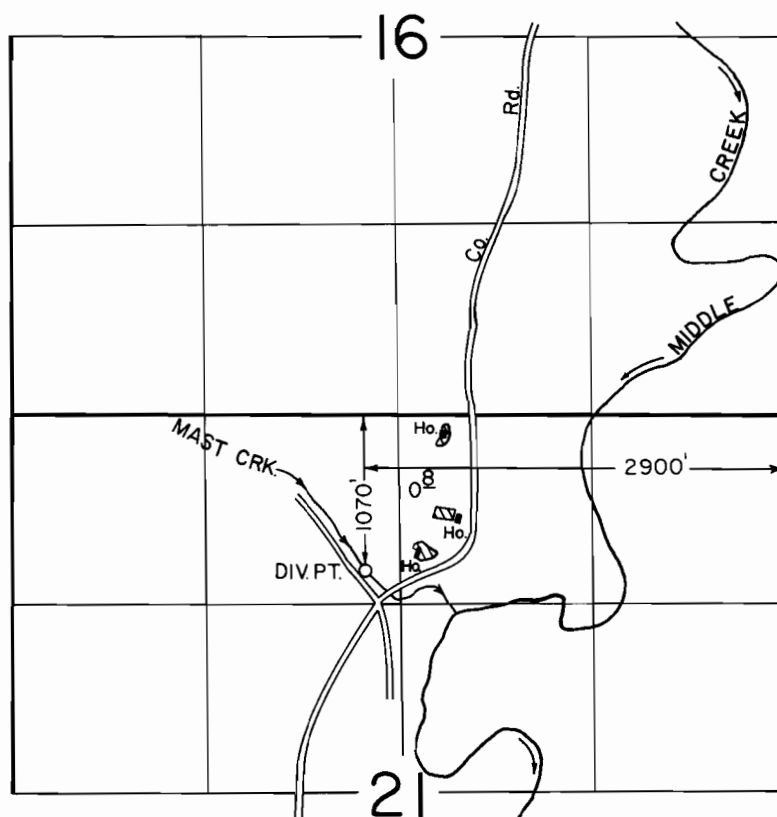

SCALE: 1" = 1320'

FINAL PROOF SURVEY UNDER

Application No. 57907 Permit No. 43798
IN NAME OF

DONALD J. & DARLENE GURNEY

Surveyed SEPT. 19, 1988, by Z. SALEH