


T. 8 S., R. 4 W., W.M.

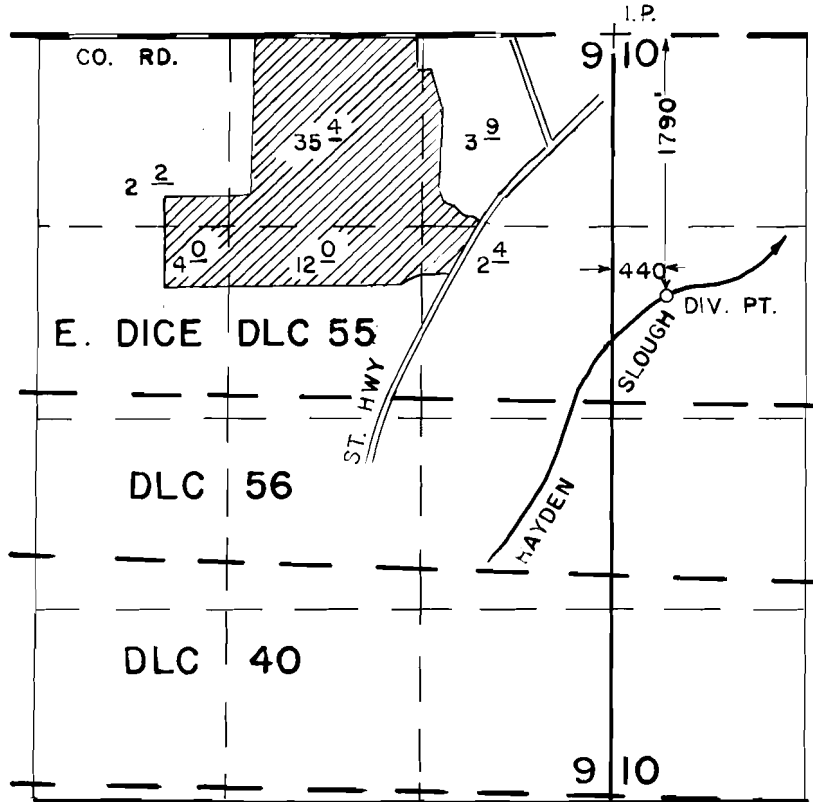

SCALE
1" = 1320'

FINAL PROOF SURVEY UNDER

Application No. 58350 Permit No. 43964
IN NAME OF

WONDERVIEW FARMS

Surveyed AUG 9 1984, by L. TOLL

PT