


RECEIVED

SEP 11 1981

WATER RESOURCES DEPT
SALEM, OREGON

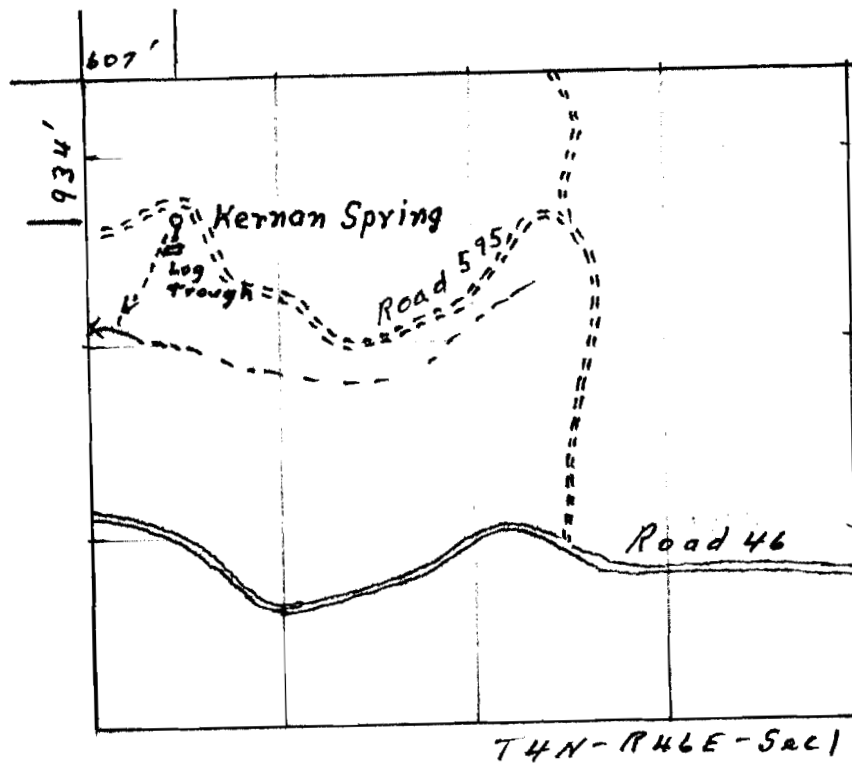

4 INCHES = 1 MILE

Application No. 62646
Permit No. 46724