


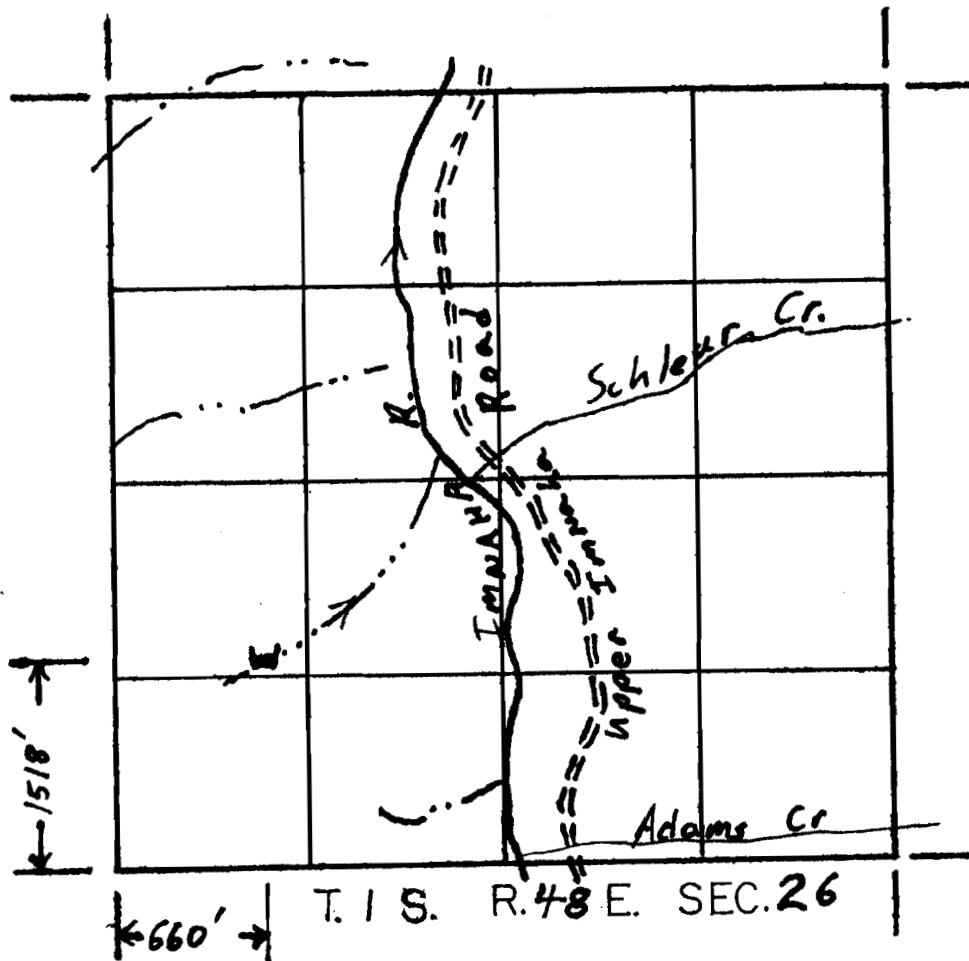

4 Inches = 1 Mile

RECEIVED

JUL 18 1983

WATER RESOURCES DEPT.
SALEM, OREGON

RECEIVED

SEP 10 1982

WATER RESOURCES DEPT.
SALEM, OREGON

Application No. 64146
Permit No. 48827

Prepared By Lloyd L. Ames