


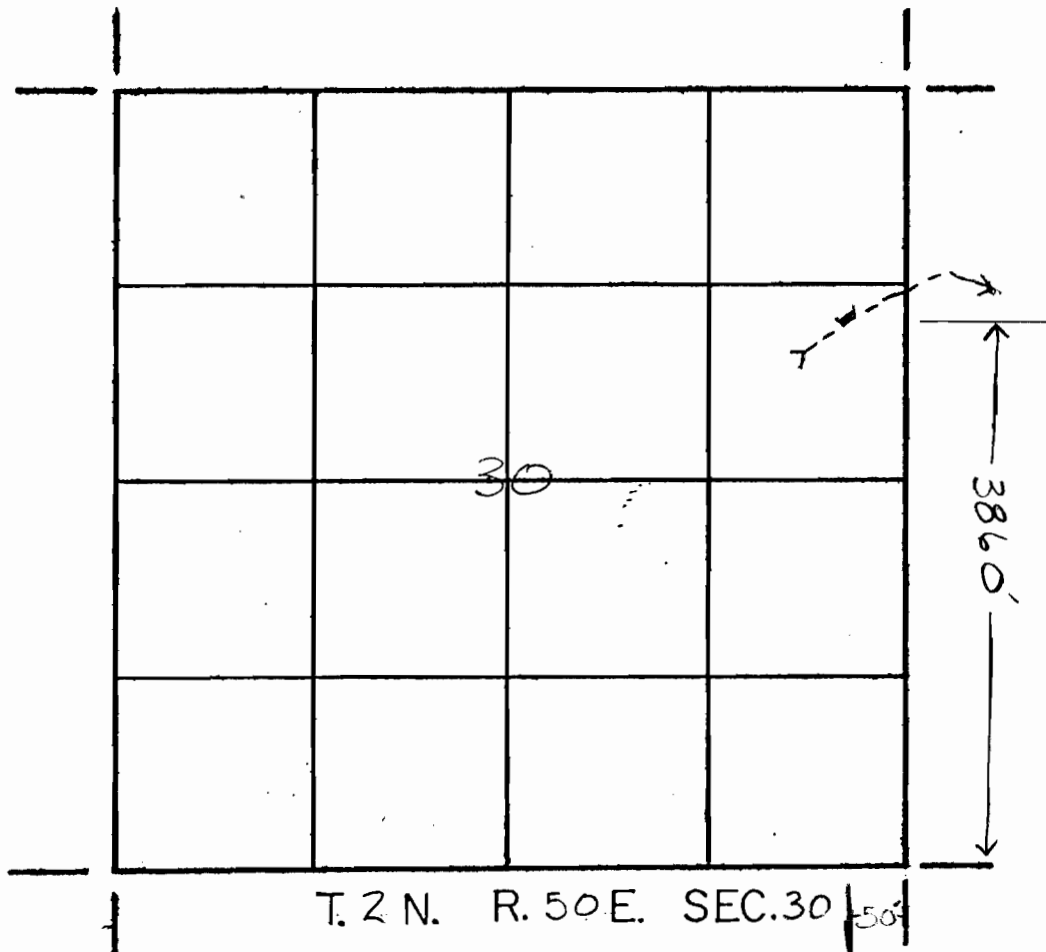

Application No. 64105
Permit No. 48829

RECEIVED

JUL 18 1983

4 Inches = 1 Mile WATER RESOURCES DEPT.
SALEM, OREGON

RECEIVED

OCT 4 1982

WATER RESOURCES DEPT.
SALEM, OREGON

Prepared By Robert J. Barney