


Application No. 64095-
Permit No. 48925

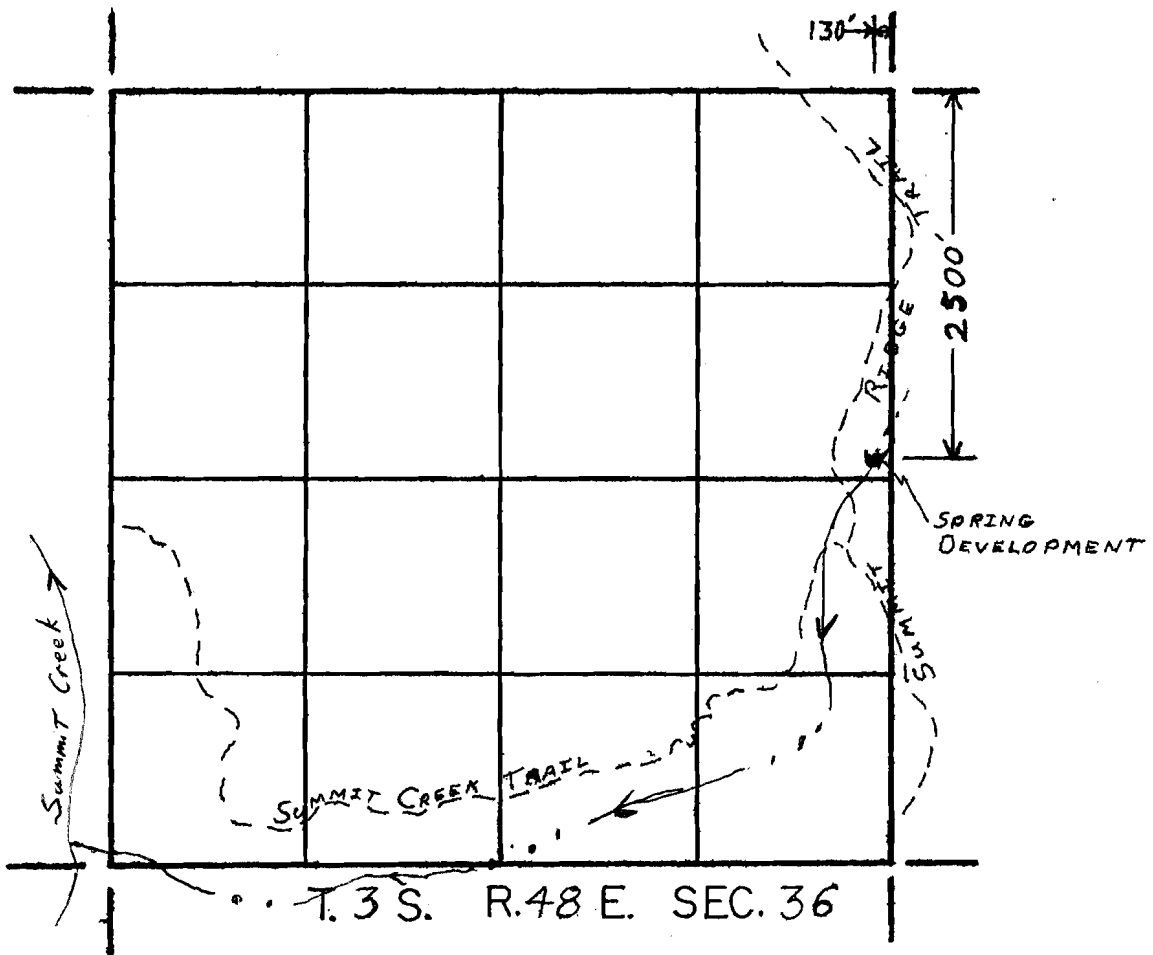

4 Inches = 1 Mile

RECEIVED

JUL 18 1983

WATER RESOURCES DEPT.
SALEM, OREGON

RECEIVED

SEP 7 1982

WATER RESOURCES DEPT.
SALEM, OREGON

Prepared By Floyd L. Ames