


Application No. 64096

Permit No. 48926

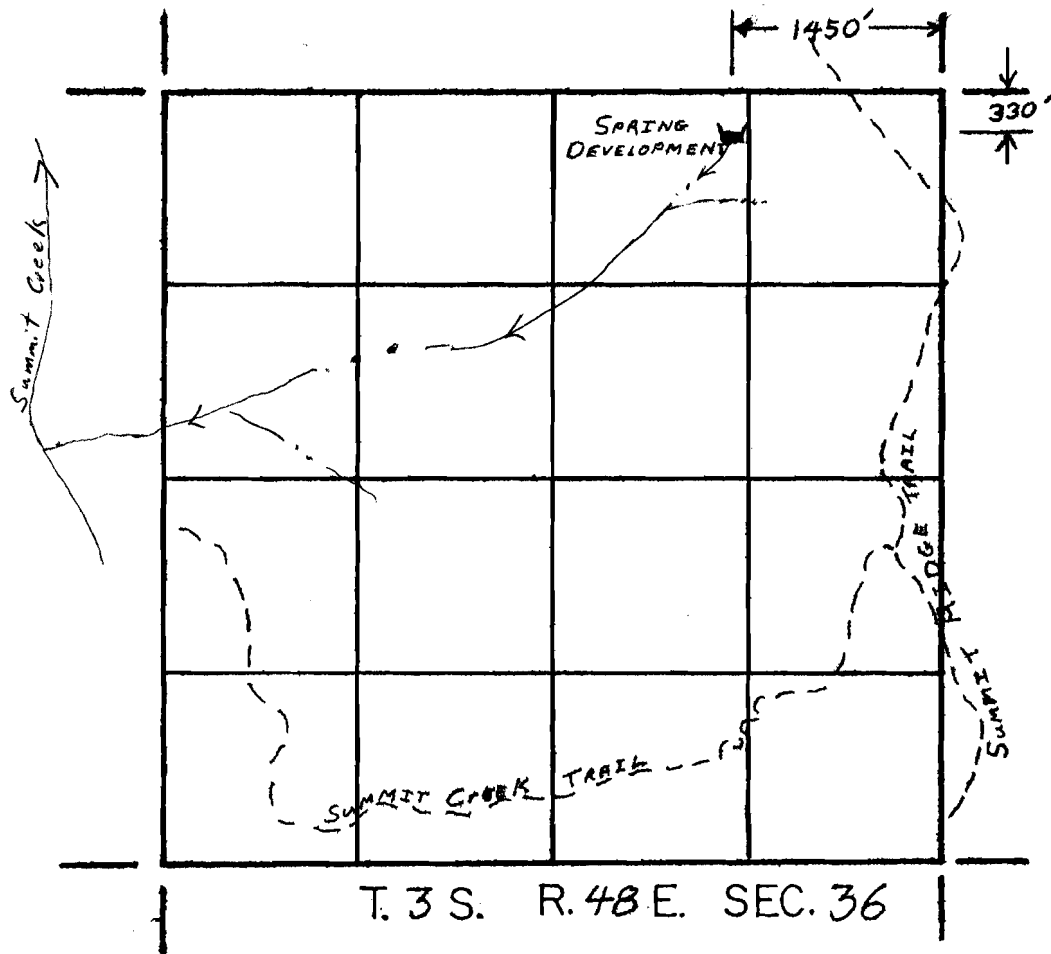

↑
N

4 Inches = 1 Mile

RECEIVED

SEP 7 1984

ATER RESOURCES DEPT
SALEM, OREGON

Prepared By Thos J. Ames