


Application No. 64097  
Permit No. 48927

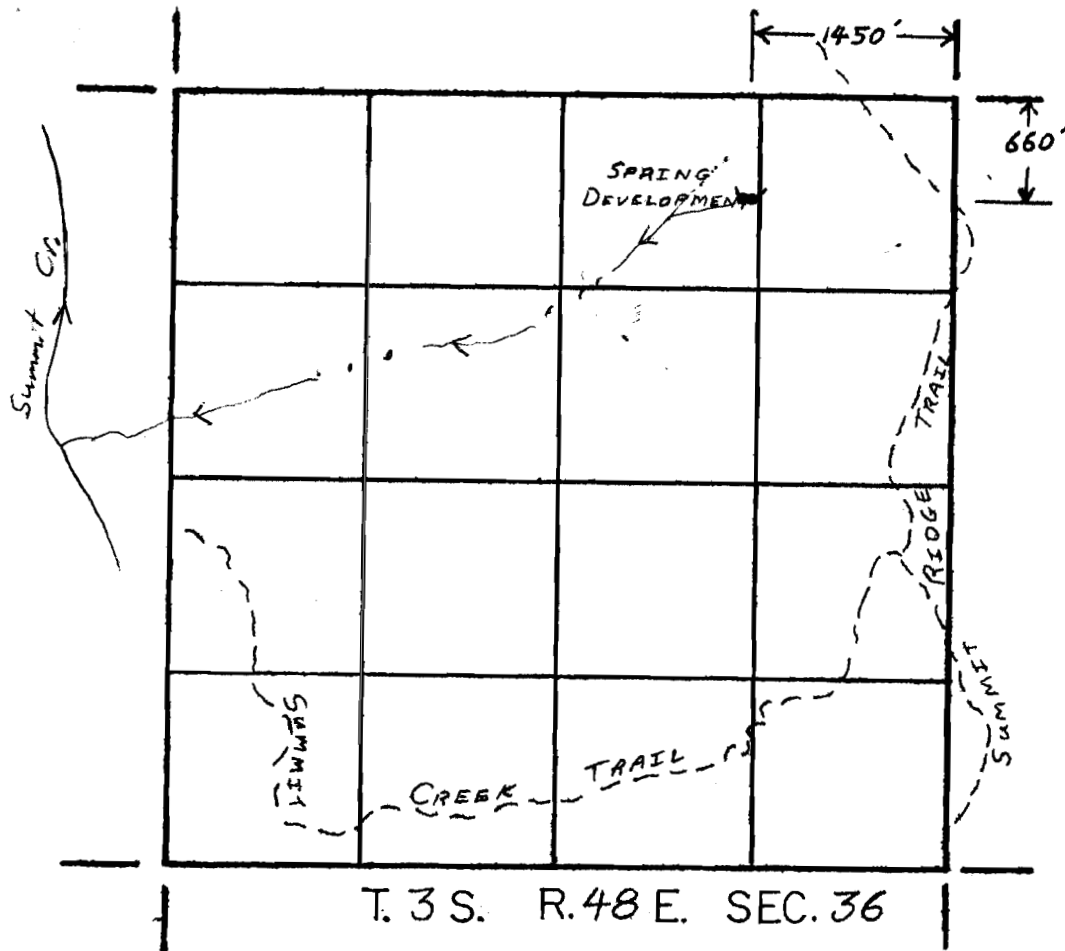

4 Inches = 1 Mile

**RECEIVED**

SEP 7 1982

WATER RESOURCES DEPT  
SALEM, OREGON

Prepared By Lloyd L. Ames