


Application No. 64098
Permit No. 48928

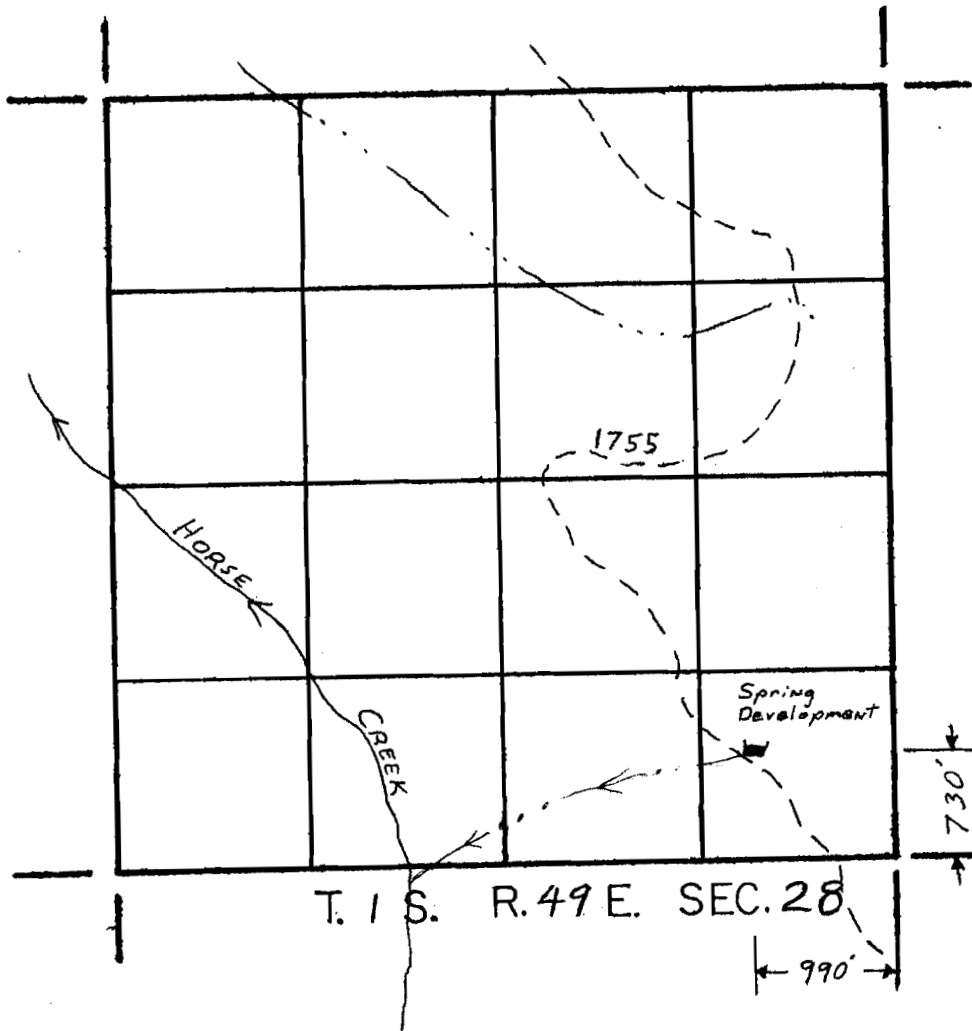

4 Inches = 1 Mile

RECEIVED
SEP 7 1982
WATER RESOURCES DEPT.
SALEM, OREGON

Prepared By Lloyd L. Ames