


Application No. 64099 -  
Permit No. 48929

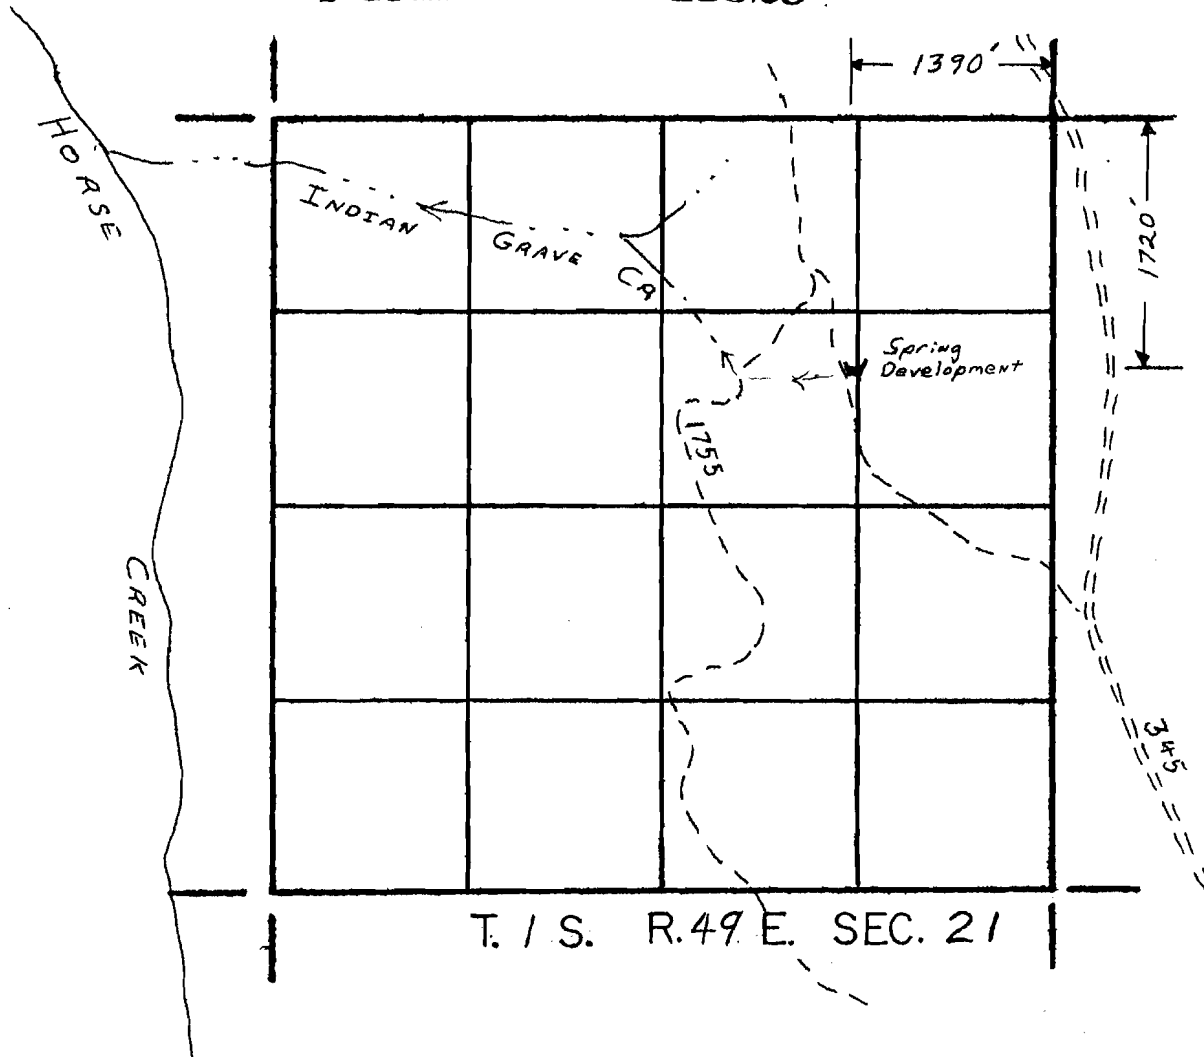

RECEIVED

SEP 7 1982

WATER RESOURCES DEPT.  
SALEM, OREGON

Prepared By Lloyd L. Ames