


Application No. 64101  
Permit No. 48931

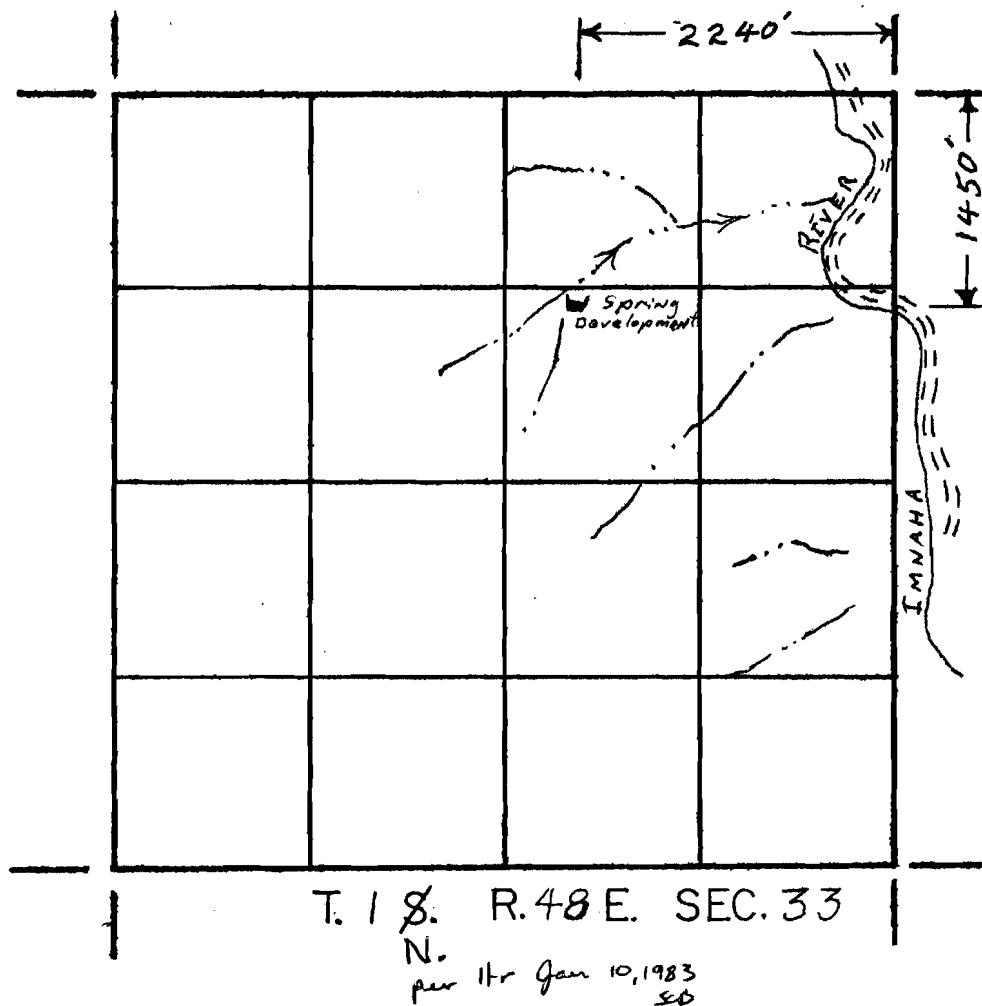

4 Inches = 1 Mile



**RECEIVED**

SEP 7 1982

WATER RESOURCES DEPT.  
SALEM, OREGON

Prepared By Lloyd L. Ames