


Application No. 64102 -  
Permit No. 48932

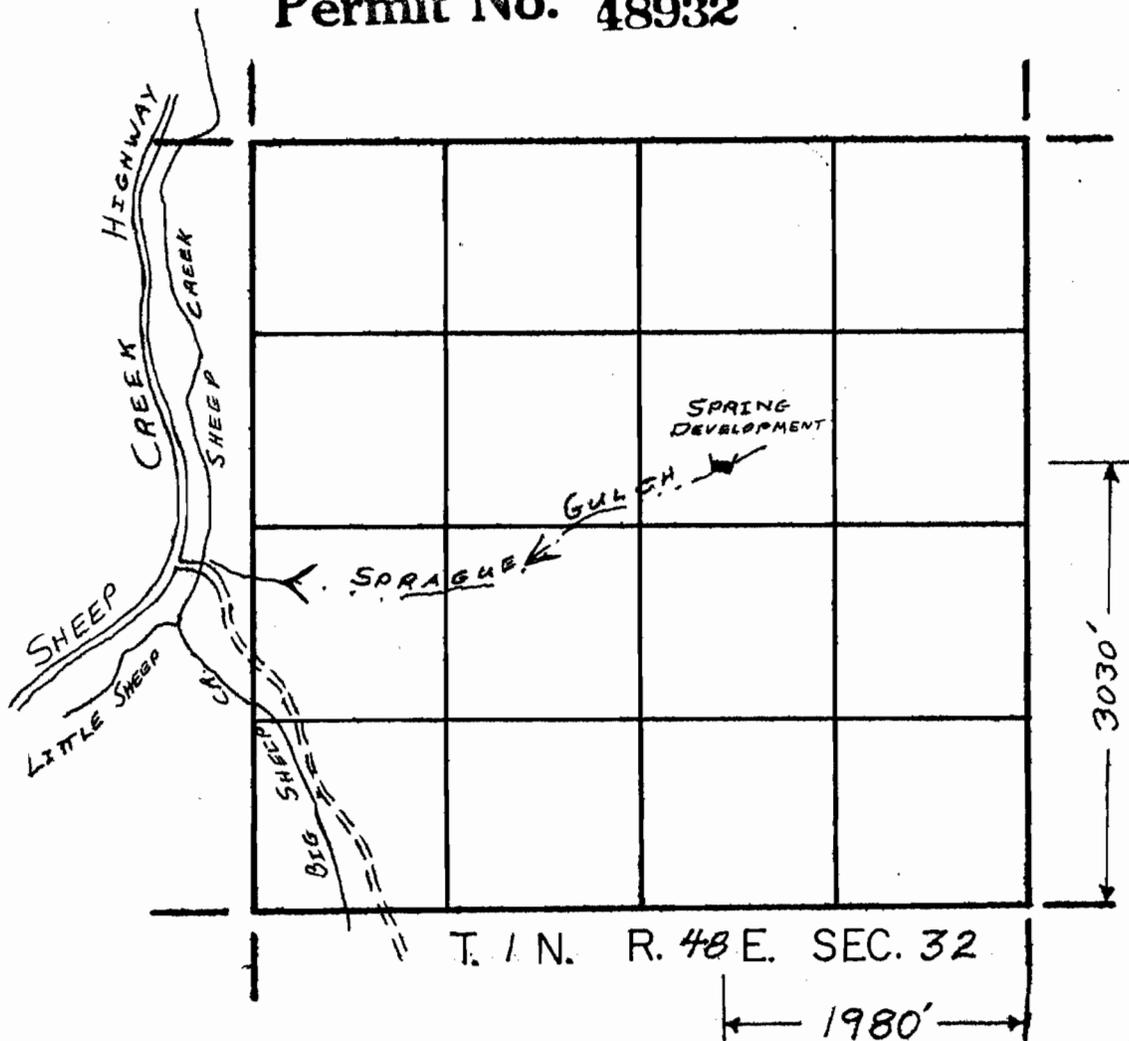

4 Inches = 1 Mile

**RECEIVED**  
SEP 7 1982  
WATER RESOURCES DEPT.  
SALEM, OREGON

Prepared By Lloyd L. Ames