


Application No. 64103
Permit No. 48933

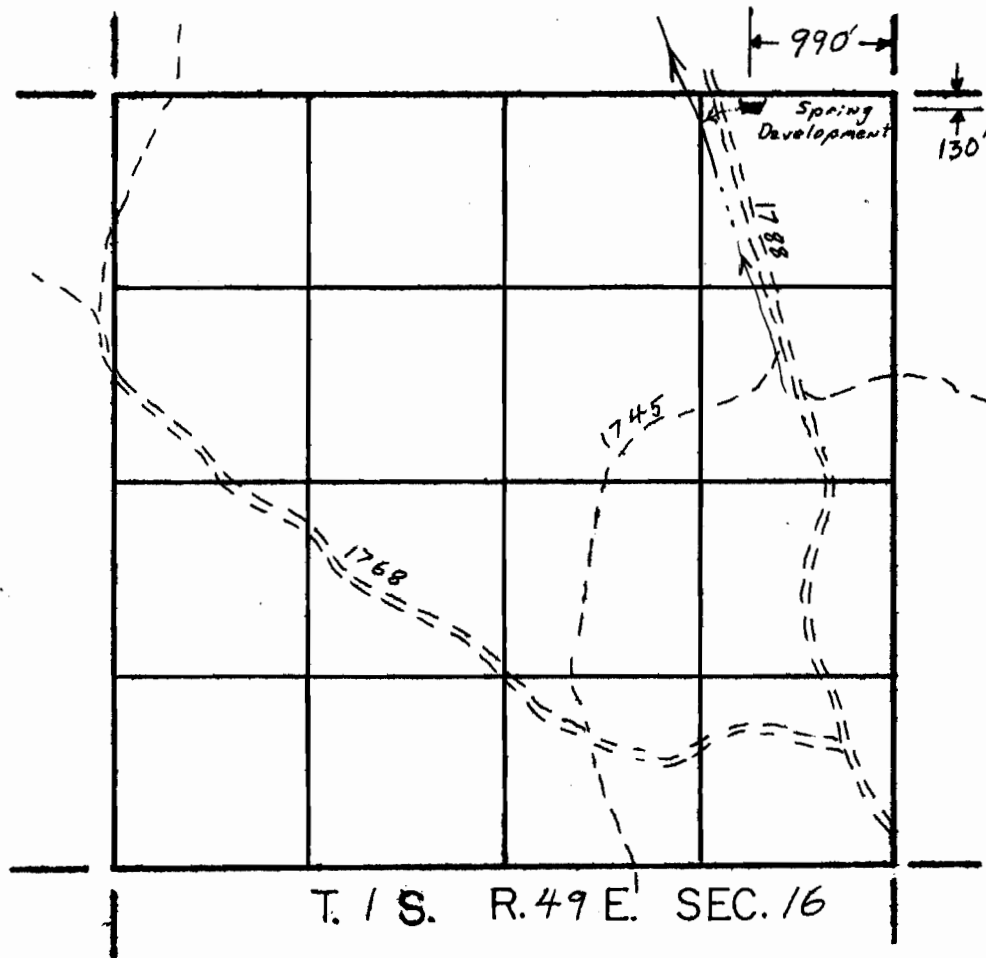

4. Inches = 1 Mile

RECEIVED

SEP 7 1982

WATER RESOURCES DEPT.
SALEM, OREGON

Prepared By Lloyd L. Ames