


Application No. 64104  
Permit No. 48934

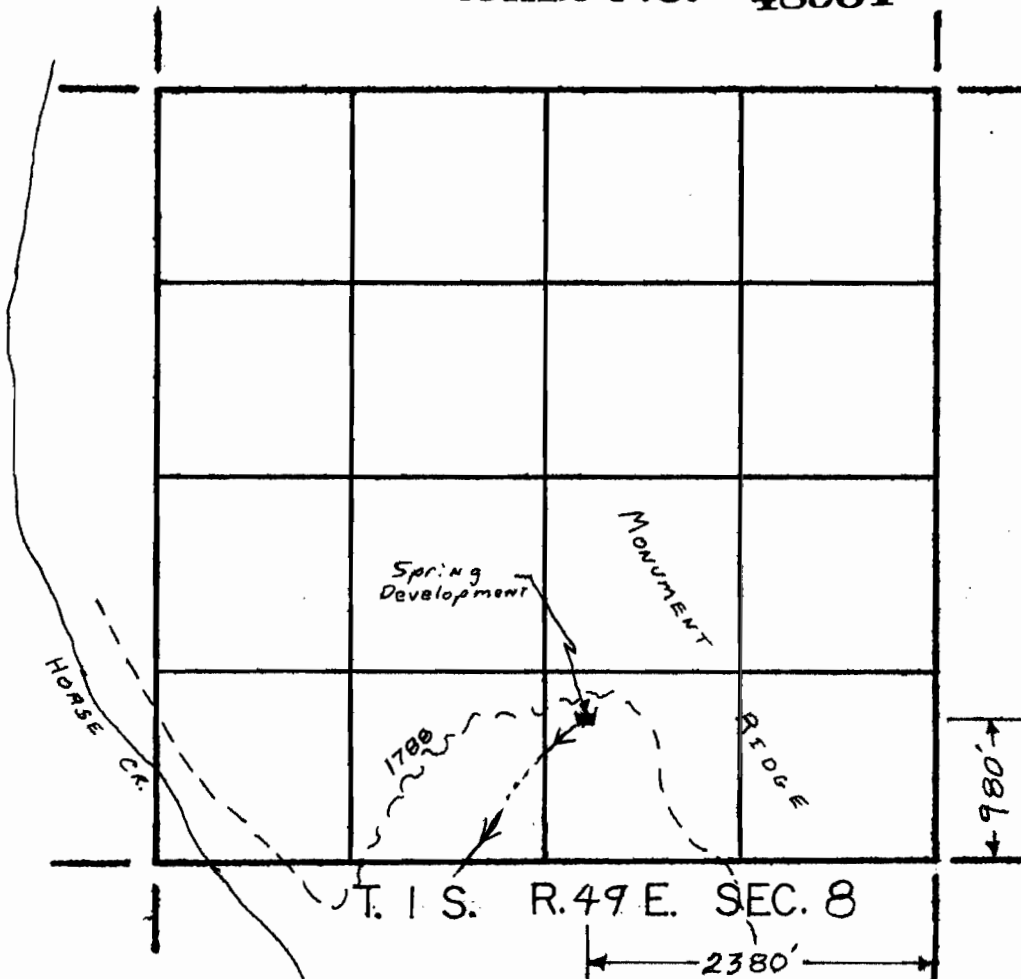

4 Inches = 1 Mile

**RECEIVED**

SEP 7 1982

WATER RESOURCES DEP.  
SALEM, OREGON

Prepared By Lloyd J. Ames