


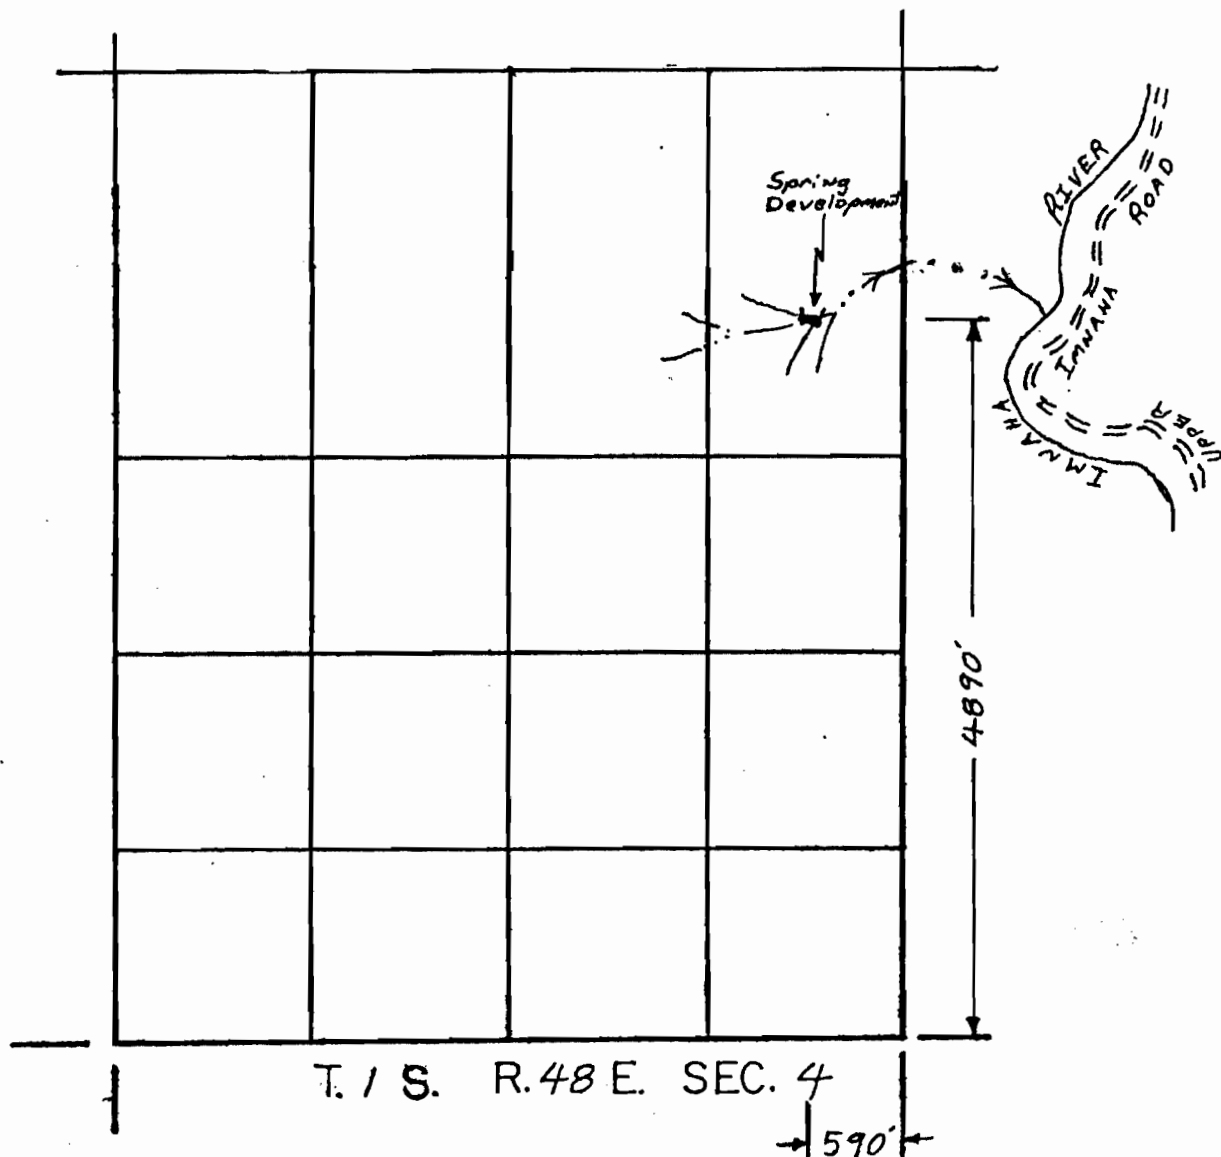

4 Inches = 1 Mile

Application No. 64105
Permit No. 48935

RECEIVED

SEP 7 1982

WATER RESOURCES DEPT.
SALEM, OREGON

Prepared By Lloyd L. Ames