


Application No. 64106
Permit No. 48936

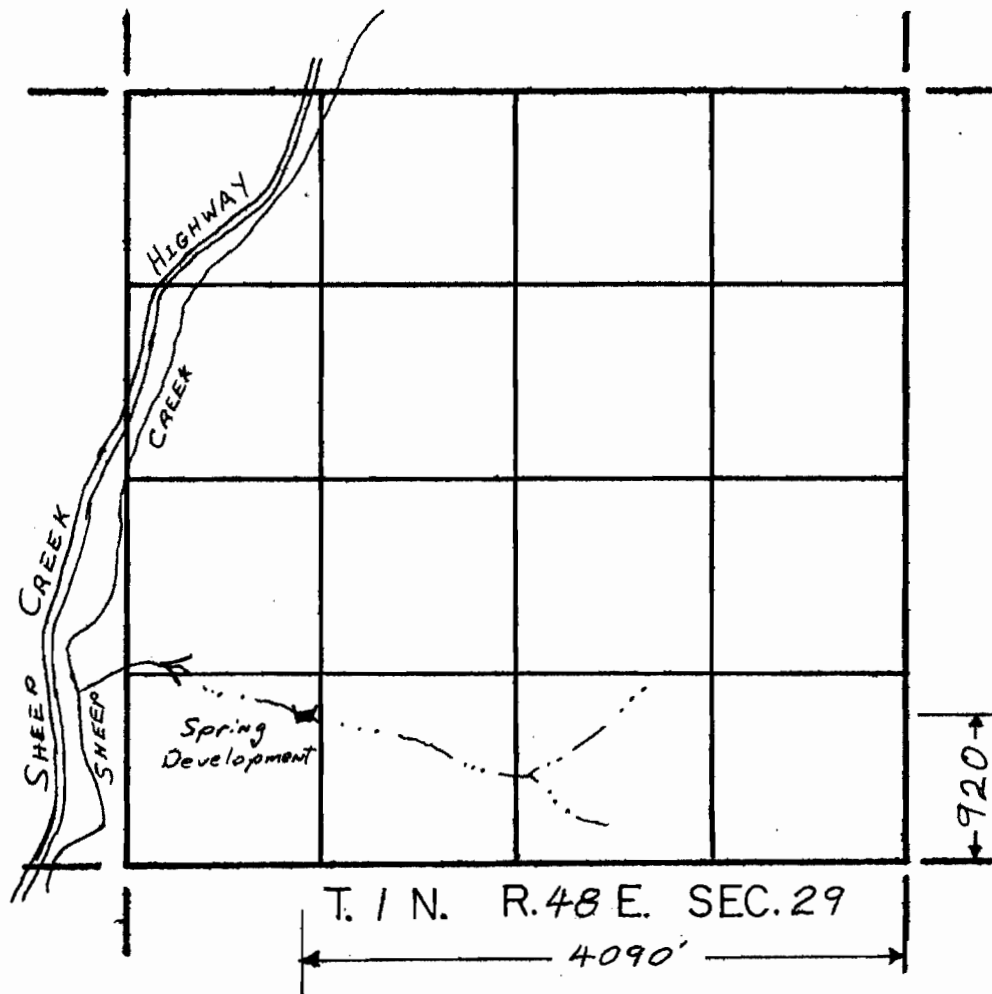

4 Inches = 1 Mile

RECEIVED

SEP 7 1962

WATER RESOURCES DEPT.
SALEM, OREGON

Prepared By Lloyd L. Ames