


Application No. 64108
Permit No. 48938

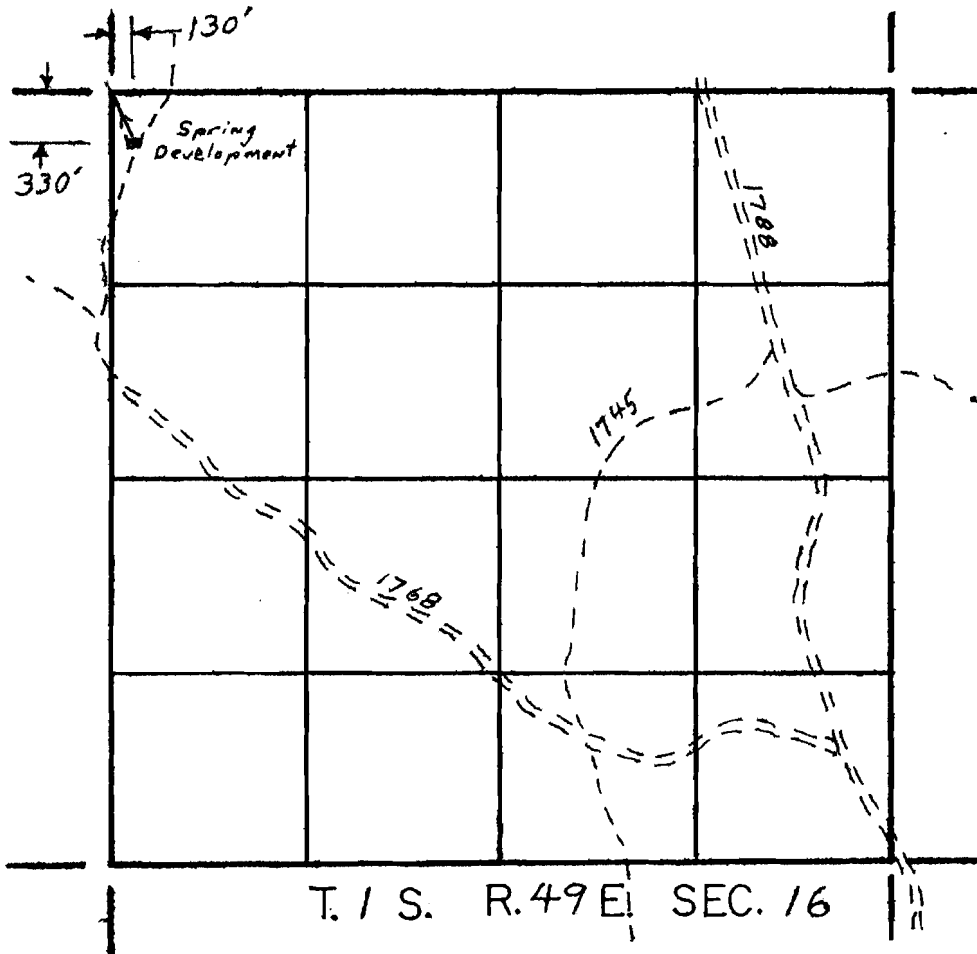

4 Inches = 1 Mile

RECEIVED

SEP 7 1982

WATER RESOURCES DEPT.
SALEM, OREGON

Prepared By Lloyd L. Ames