


Application No. 64109
Permit No. 48939

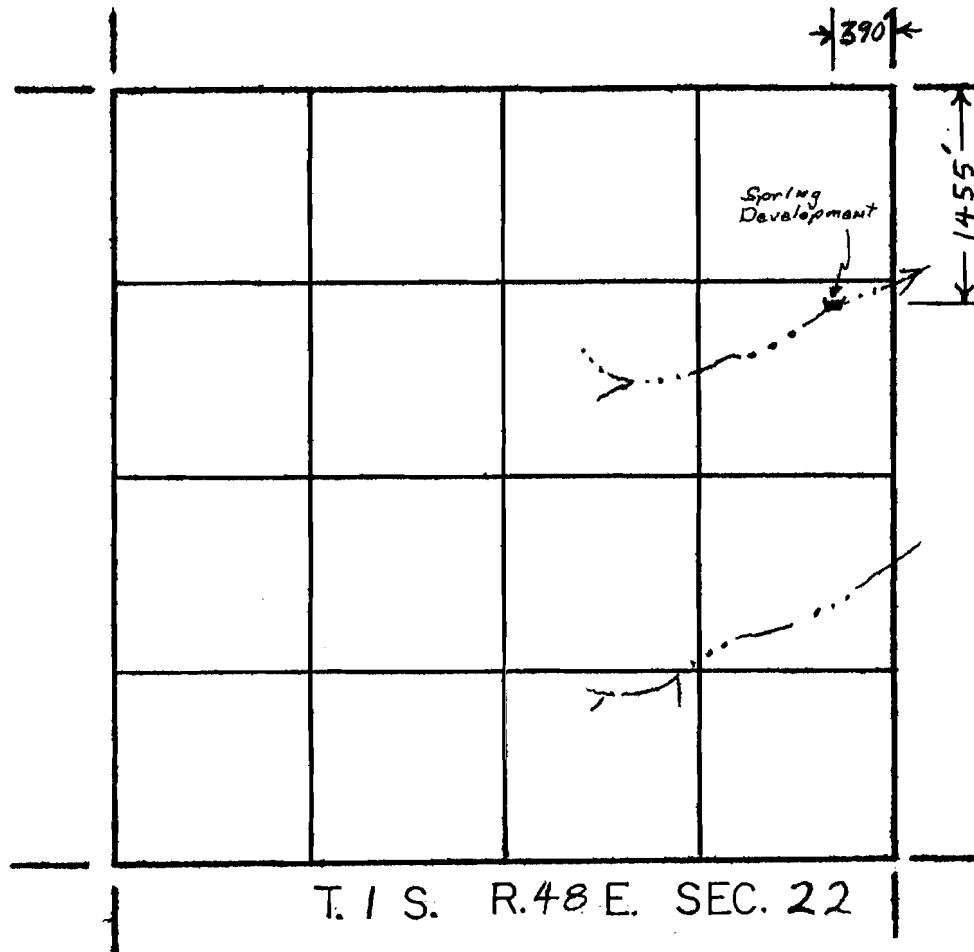

4 Inches = 1 Mile

RECEIVED

SEP 7 1982

WATER RESOURCES DEPT.
SALEM, OREGON

Prepared By Lloyd S. Ames