


Application No. 64110  
Permit No. 48940

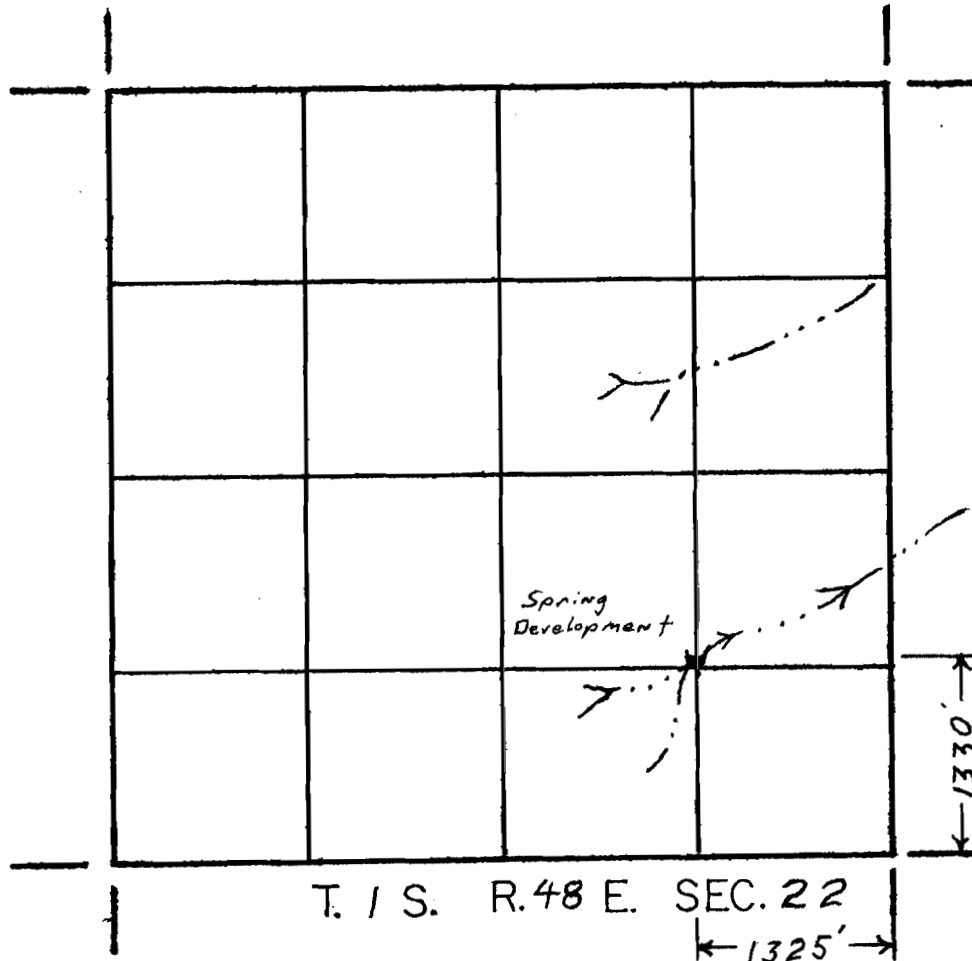

4 Inches = 1 Mile

**RECEIVED**

SEP 7 1982

WATER RESOURCES DEPT.  
SALEM, OREGON

Prepared By Lloyd J. Ames