


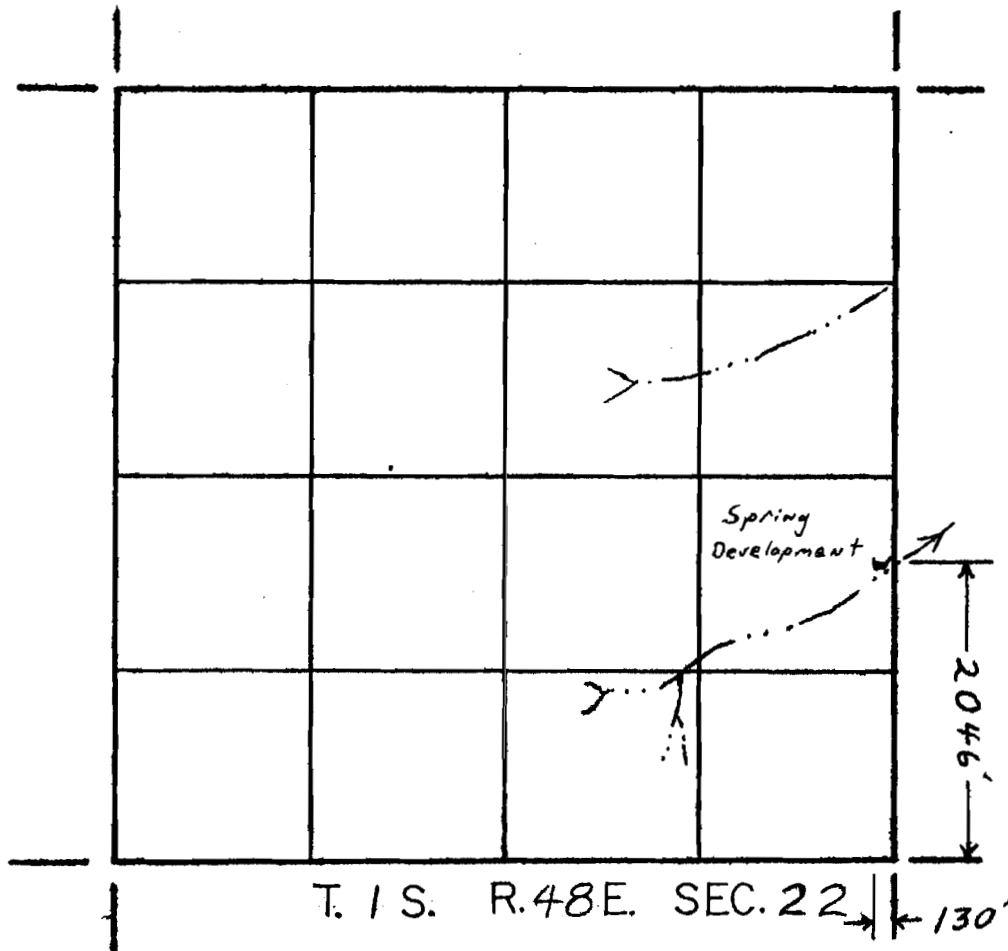

4 Inches = 1 Mile

RECEIVED
 SEP 10 1982
 WATER RESOURCES DEPT.
 SALEM, OREGON

Application No. 64142
 Permit No. 48941

Prepared By Lloyd L. Ames