


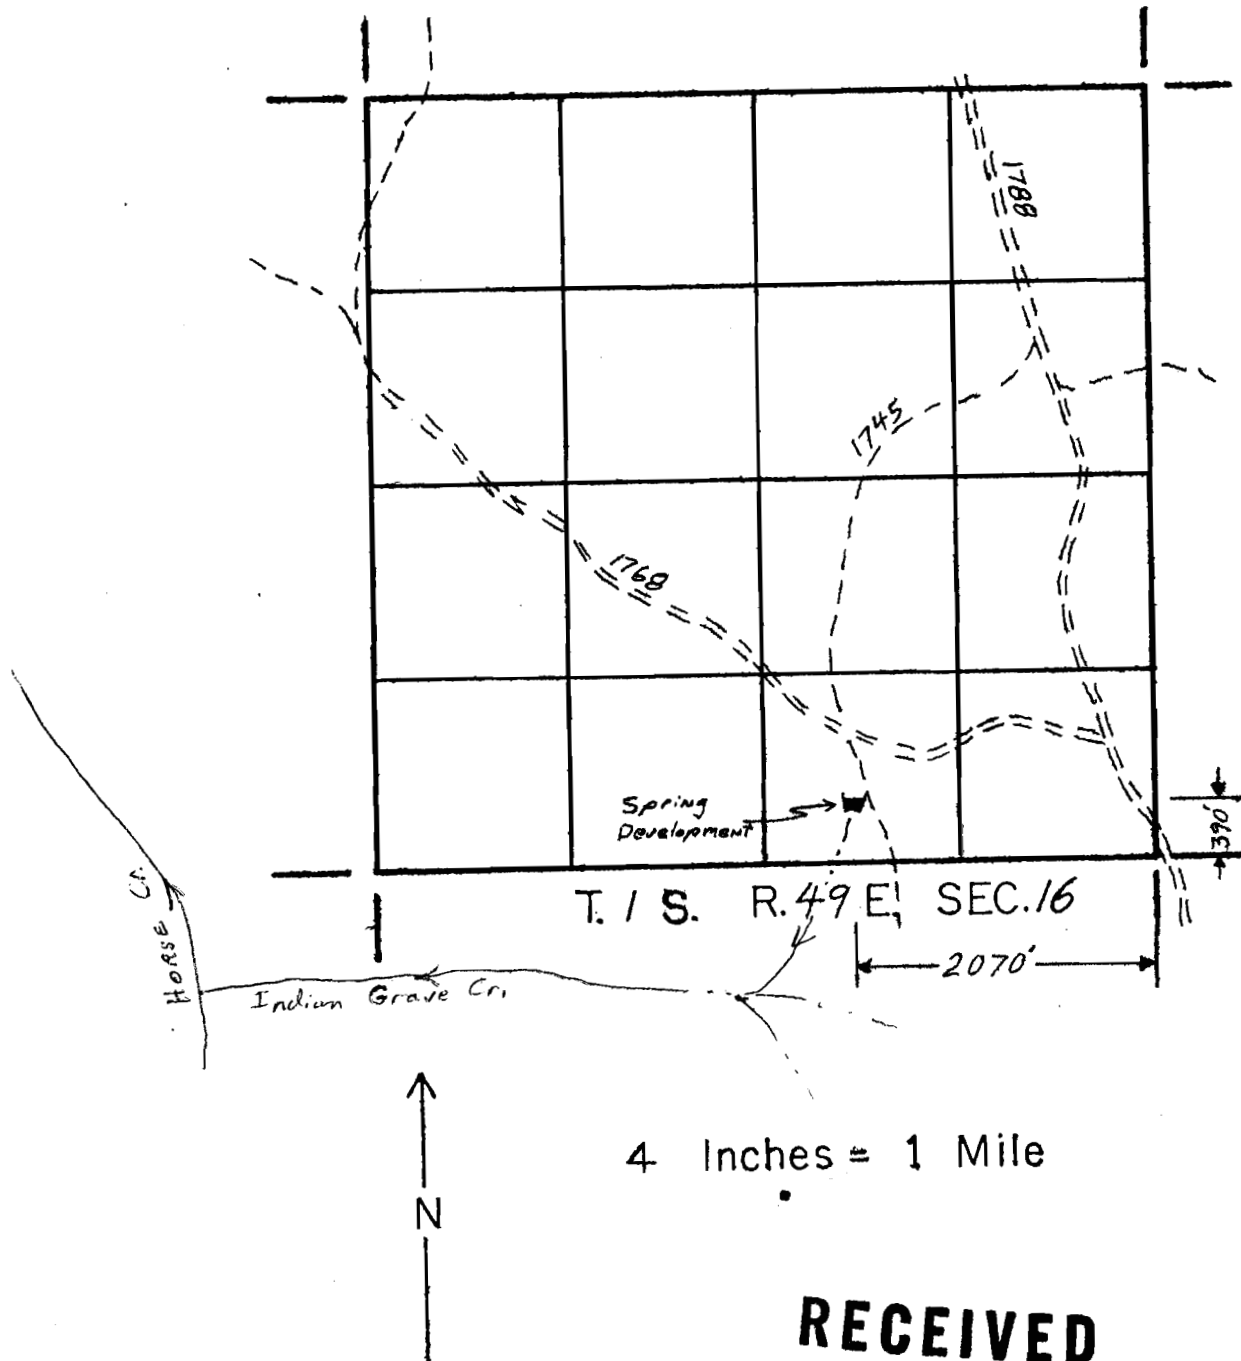

RECEIVED
 SEP 10 1982
 WATER RESOURCES DEPT.
 SALEM, OREGON

Application No. 64143
 Permit No. 48942

Prepared By Lloyd L Ames