


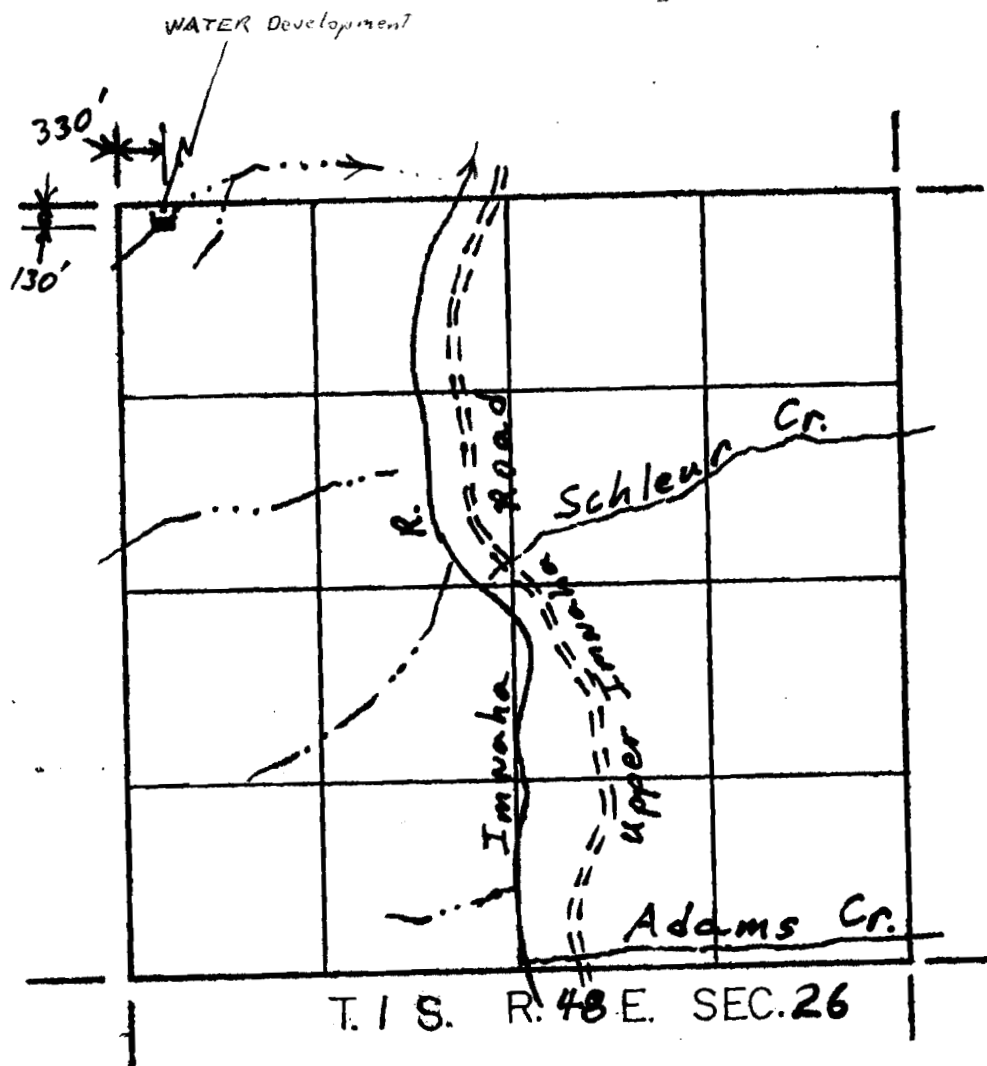

4 Inches = 1 Mile

RECEIVED

SEP 10 1982

WATER RESOURCES DEPT.
SALEM, OREGON

Application No. 6415
Permit No. 48944

Prepared By Lloyd L. Ames