


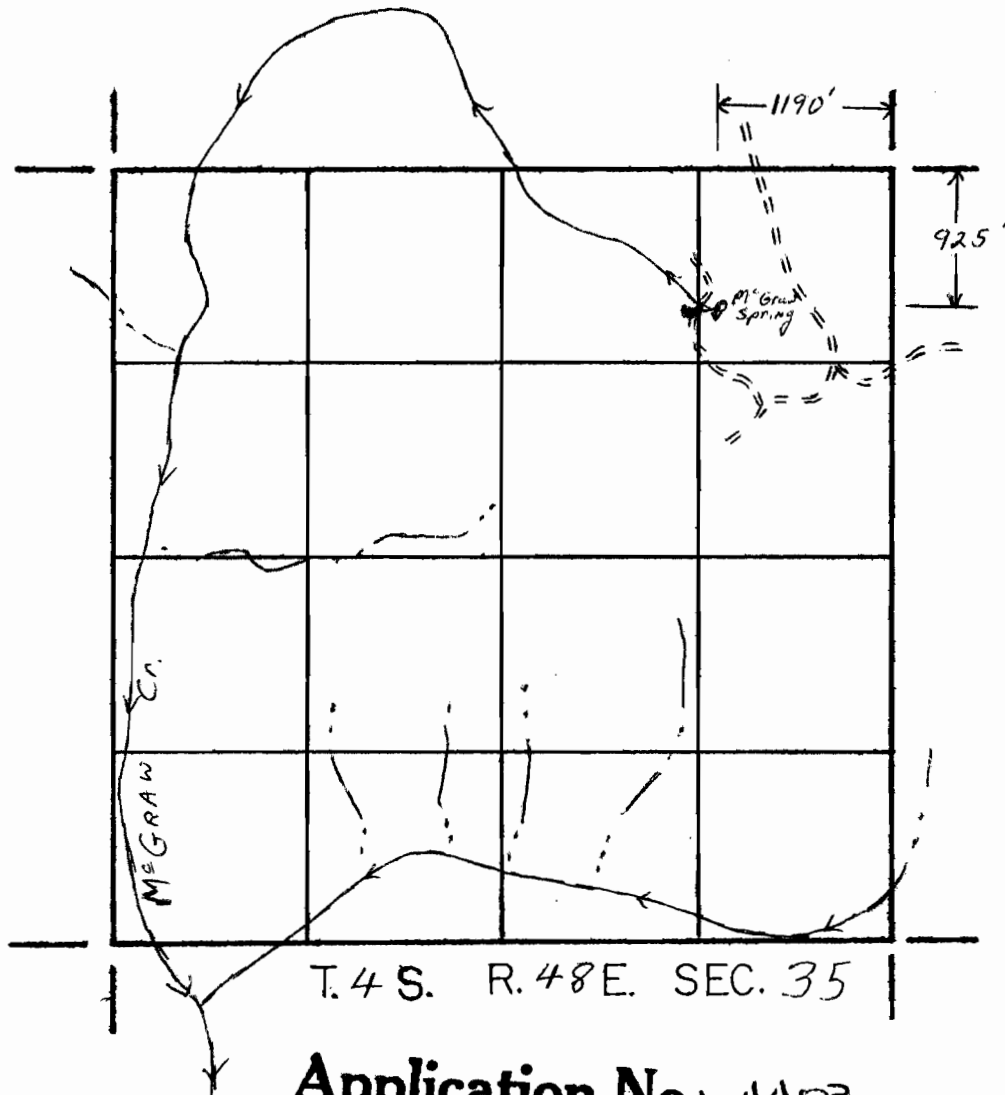

Application No. 64403
Permit No. 48947

4 Inches = 1 Mile

RECEIVED

OCT 4 1982

WATER RESOURCES DEPT.
SALEM, OREGON

Prepared By Lloyd L. Ames