




Application No. 644104
Permit No. 48948

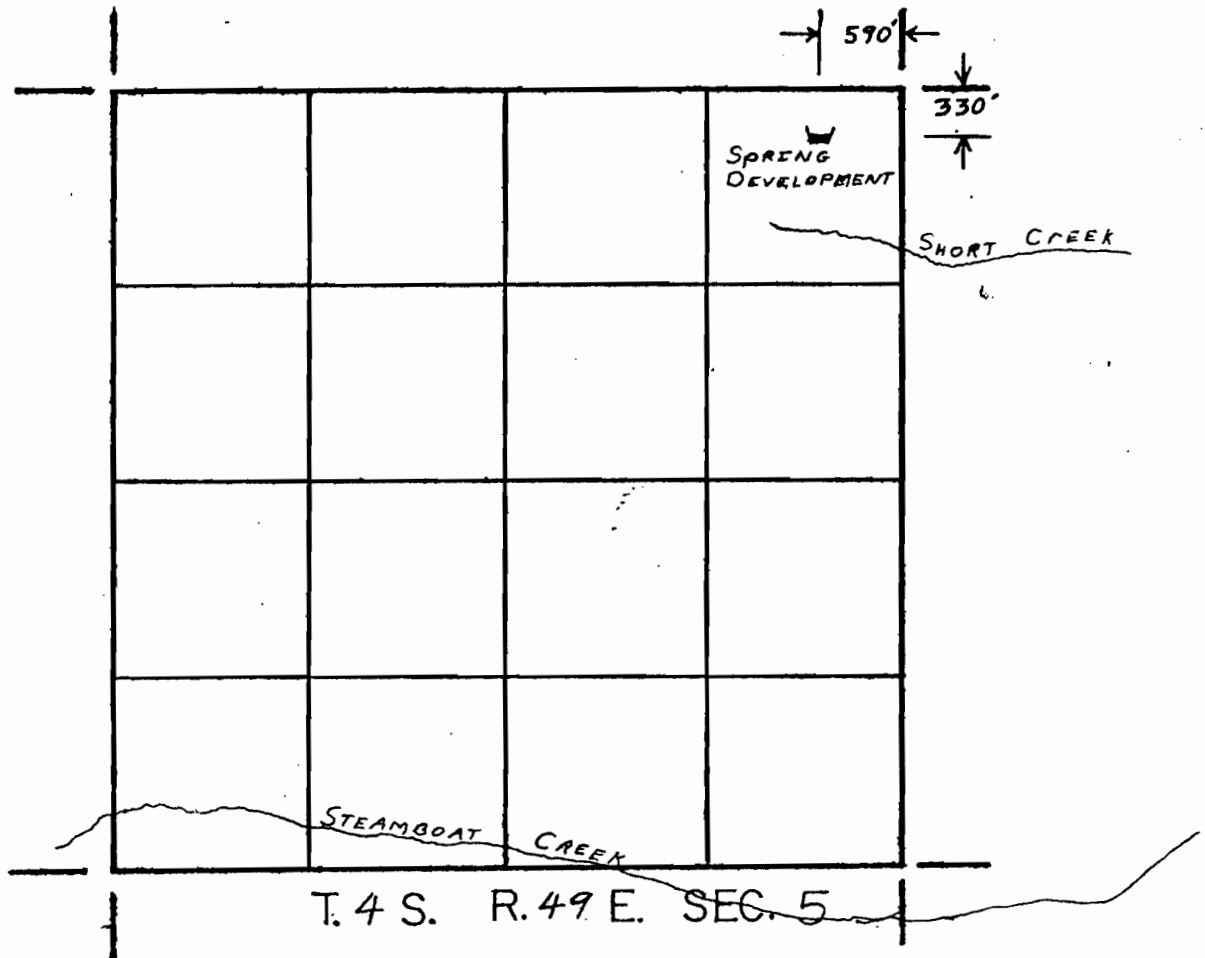

4 Inches = 1 Mile

RECEIVED
OCT 4 1982
WATER RESOURCES DEPT.
SALEM, OREGON

Prepared By Lloyd L. Ames