


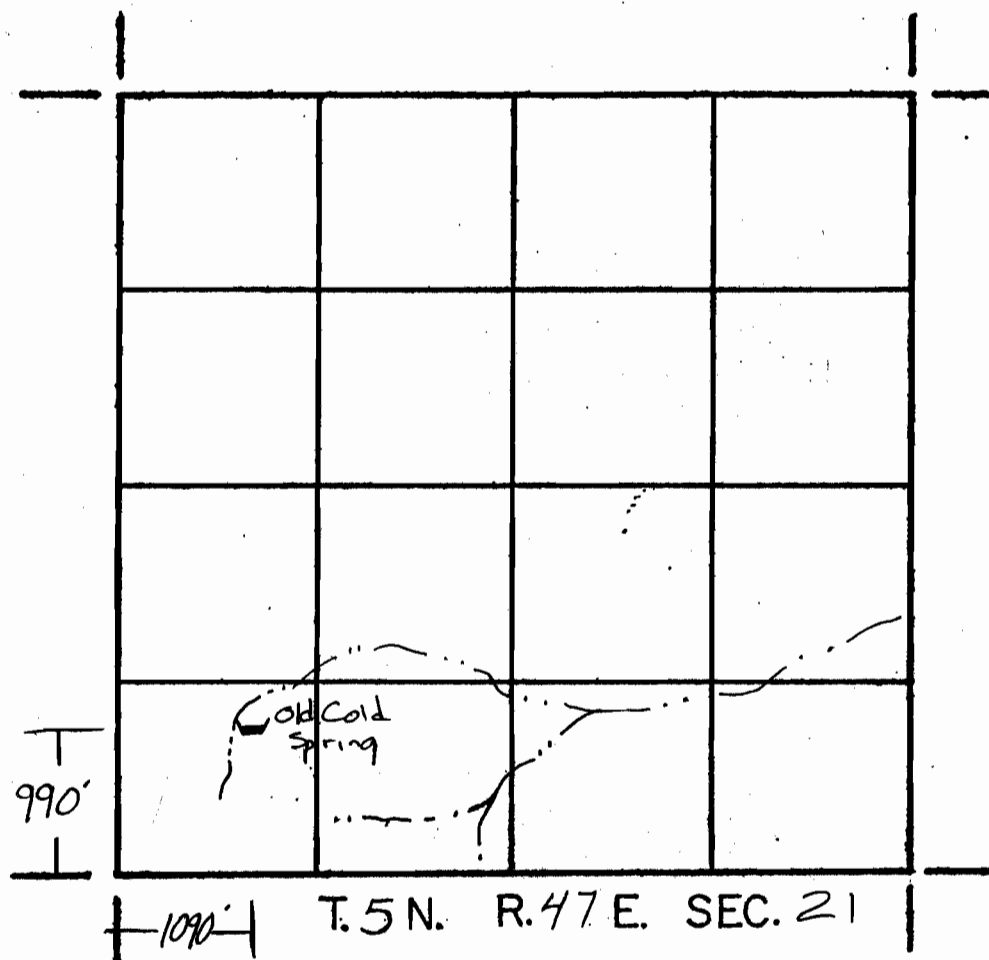

Application No. 64406
Permit No. 48949

4 Inches = 1 Mile



Prepared By ROBERT J. BARNEY