




Application No. 64407
 Permit No. 48950

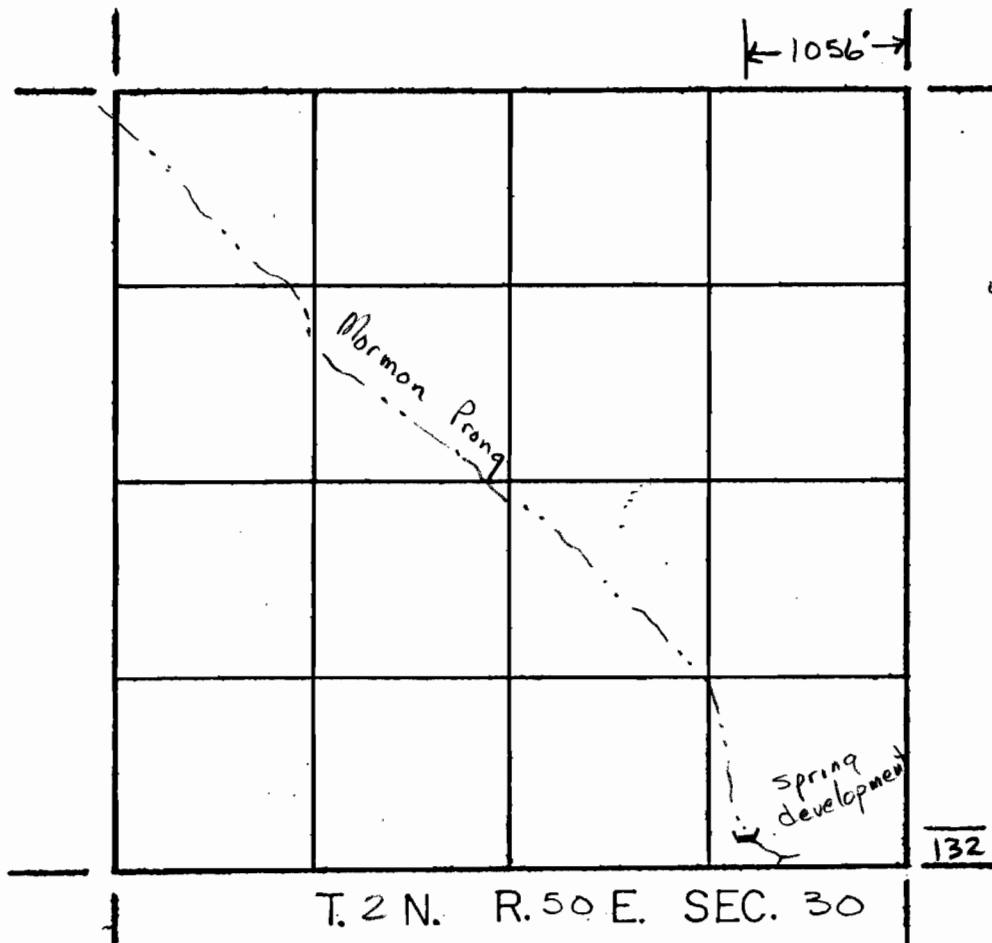

4 Inches = 1 Mile

RECEIVED
 OCT 4 1982
 WATER RESOURCES DEPT.
 SALEM, OREGON

Prepared By Robert J. Barney