


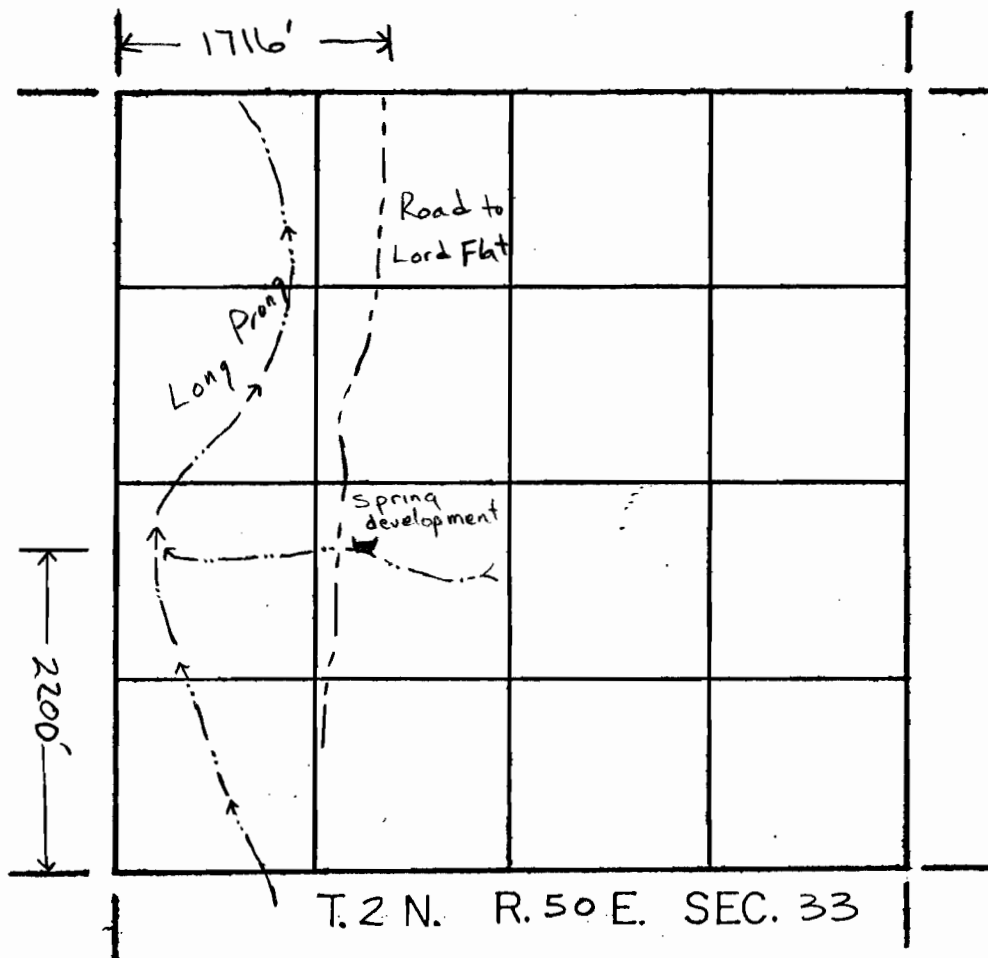

Application No. 64408
Permit No. 48951

4 Inches = 1 Mile



RECEIVED

OCT 4 1982

WATER RESOURCES DEPT.
SALEM, OREGON

Prepared By Robert J. Barney