


RECEIVED

OCT 18 1983

WATER RESOURCES DEPT.
SALEM, OREGON

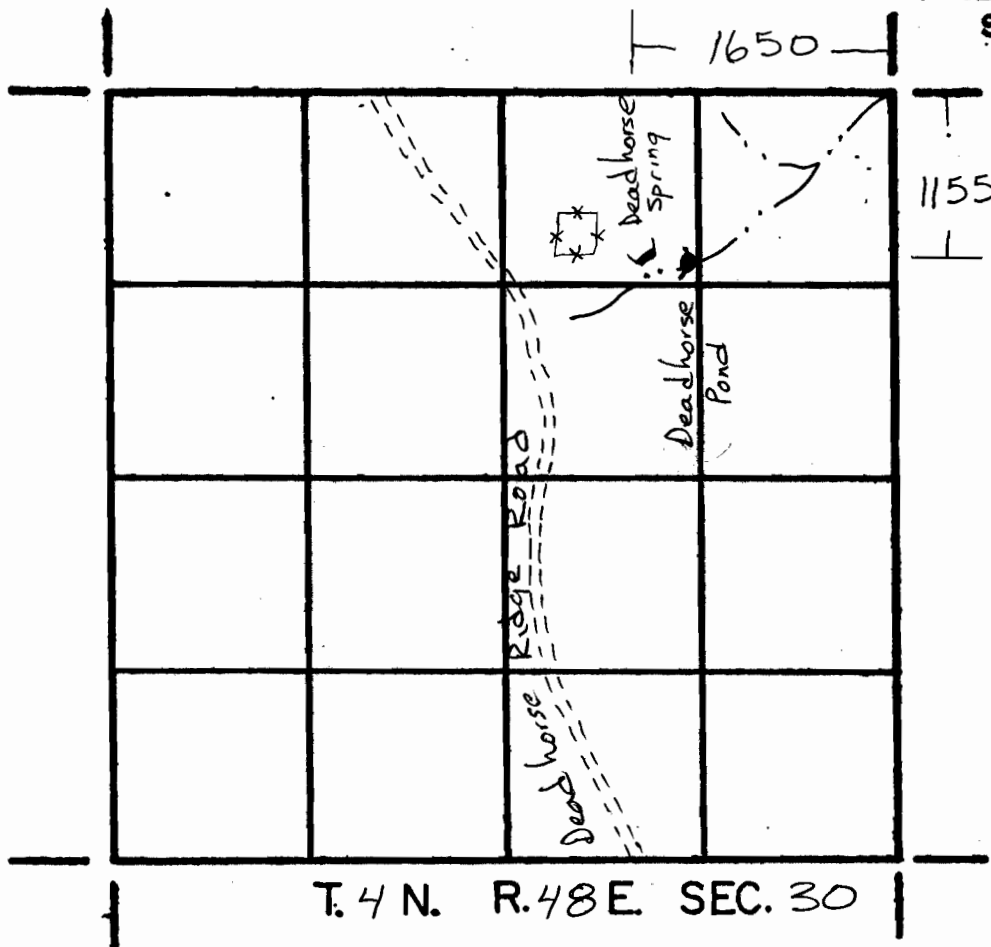

4 Inches = 1 Mile

Application No. 67575
Permit No. 49105

Prepared By Robert J. Banning