


RECEIVED

OCT 13 1983

WATER RESOURCES DEPT
SALEM, OREGON

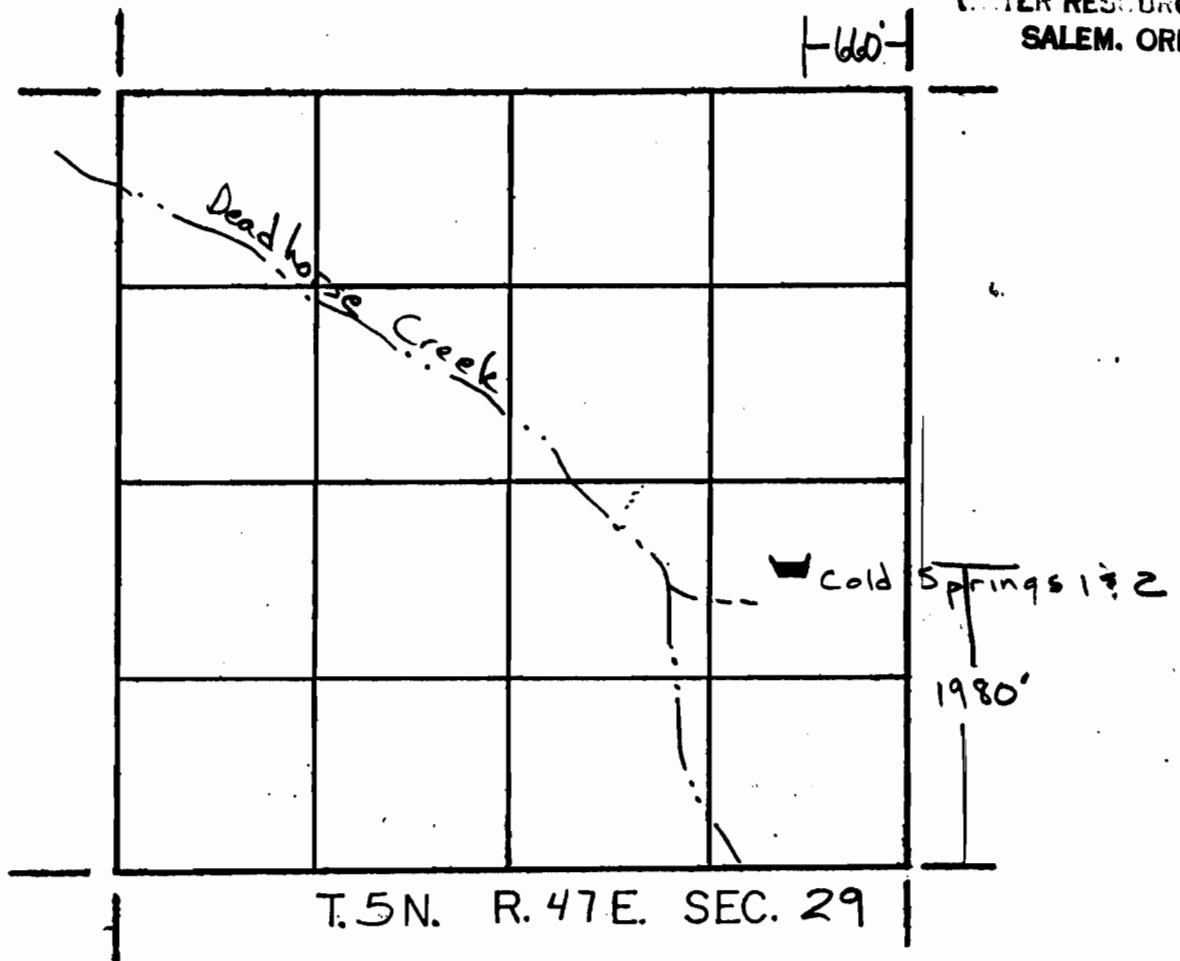

4 Inches = 1 Mile

Application No. 67576
Permit No. 49106

Prepared By _____