


**RECEIVED**

**OCT 13 1983**

**WATER RESOURCES DEPT.  
SALEM, OREGON**

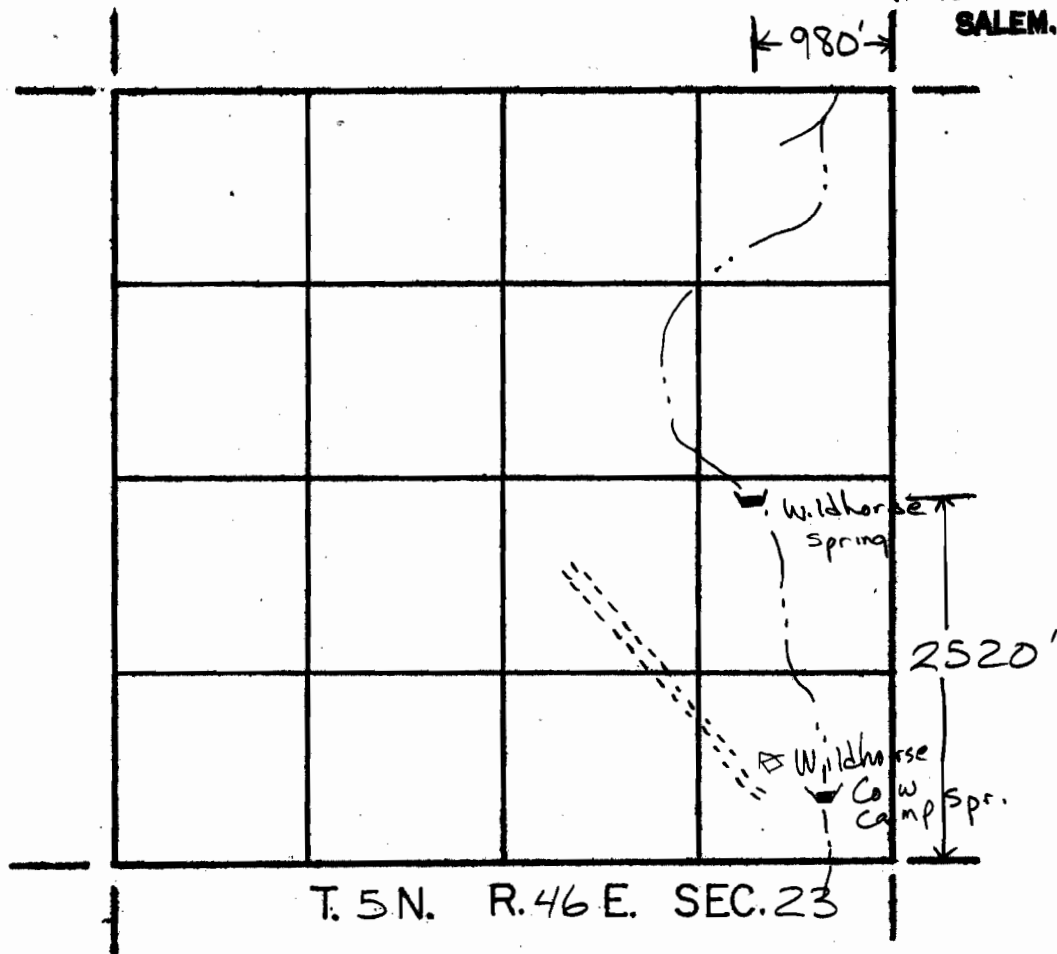

4 Inches = 1 Mile

**Application No. 67577**  
**Permit No. 49107**

Prepared By Robert J. Sawyer